LAND CORNER RECORDATION CERTIFICATE

Filing Requirement of Act 74, Mich. P.A. 1970

For corners in OSCEOLA (County)

	Located In:	Corner Code ##
1. Public Land Survey	T 19N R 9W	H-8
	T ____ R ____	I-8
	T ____ R ____	
	T ____ R ____	
2. Property Controlling	S 22 T ____ R ____	9
in Section	S 22 T ____ R ____	16
3. Miscellaneous	S ____ T ____ R ____	
Property in Sec.	S ____ T ____ R ____	

Register of Deeds Stamp & File Number

4. Lot No. _____ , Recorded Plat _____

5. Private Claims _____

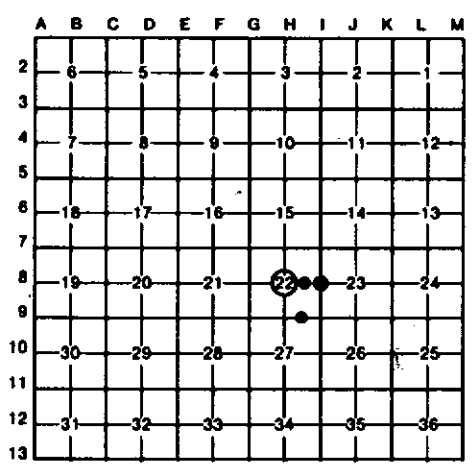

I, CARL F. ROSER, in a field survey on 04/18, 19 84, do hereby certify that under requirements of P.A. 74, Michigan P.A. of 1970, the corner points mentioned in lines 1 and 2 above were in conformance with regulations and rules therefore as required in the current manual of survey instructions of the United States Department of the Interior, Bureau of Land Management or by a decree of a Court of Law and/or that the corner points mentioned in lines 3, 4 and 5 above were in conformance with the rules of the Michigan Board of Land Surveyors or by a Decree of a Court of Law; established, re-established, monumented, re-monumented, recovered, found as expressed below:

NOTE: Not more than 4 corners, all in the same town and range, may be recorded on this certificate.

A. Description of original monument and accessories and/or subsequent restoration:

H-8	I-8	9	16

B. Description of corner evidence found and/or method applied in restoring or reestablishing corner:

H-8	I-8	9	16
ESTAB. CTR. OF SEC.22 AT INTERSECTION OF ONE-QTR.LINE'S OLD E-W FN. IS N 20.5' & OLD N-S FN IS E 21'.	FD. CO. SURVEYOR A.O.TEMPLE'S IRON ROD IN TILE IN OLD N-S FENCE. TEMPLE HAD US-B.T'S HERE IN 1892.	ESTAB. NE COR. OF W 1/2-SE 1/4 OF SEC.22 PER STD. B.L.M. IN-STRUCTIONS. AT SW COR OF FIELD THERE IS AN OLD FN COR. ON GRD. (FN REMAINS E-W-N), N37°E, 65'.	ESTAB. SE COR. OF W 1/2-SE 1/4OF SEC.22 PER STD. B.L.M. IN-STRUCTIONS.

C. Description of monument for corner and accessories established to perpetuate locating the position of the corner:

H-8	I-8	9	16
DROVE 5/8" X 34" RE-ROD W/RLS CAP & CED. POST W/LOC.TAG.	FD 1/2" IRON ROD IN TILE,ADDED CED POST W/LOC. TAG.	DROVE 5/8" X 34" RE-ROD W/RLS CAP & CED POST W/LOC. TAG.	DROVE 5/8" X 34" RE-ROD W/RLS CAP & CED POST W/LOC TAG.
5" MAPLE N20°W 26.7'	16" SUG.MAPLE N40°W 3.0'	4 " MAPLE N 5°E 26.3'	10" W.OAK N15°W 48.0'
7" R.OAK N30°E 27.0'	22" SUG.MAPLE N80°E 42.8'	10" MAPLE N65°E 48.9'	10" W.OAK N 5°W 33.8'
6" R.OAK S30°E 9.5'	4" W.ASH S45°E 45.3'	4 "B.CHERRY S55°W 28.0'	2" MAPLE S25°E 59.2'
OLD FN COR N44°E 28'	21" SUG.MAPLE S30°W 23.8'		COR OF OLD FN'S W & S S78°W 9'

Signed by Carl F. Roser 02-05-91 Date _____

Surveyor's Michigan License No. 12028

STATE OF MICHIGAN CARL F. ROSER LAND SURVEYOR No. 12028 REGISTERED LAND SURVEYOR

FORM APPROVED BY MICHIGAN STATE BOARD OF LAND SURVEYORS, JAN. 28, 1971 AMD. MAY 14, 1975 AMENDED JAN., 1983