LAND CORNER RECORDATION CERTIFICATE

Filing Requirement of Act 74, Mich. P.A. 1970

For corners in
OSCEOLA
(County)

	Located In:	Corner Code ##
1. Public Land Survey	T 19N R 9W	H-7
	T ____ R ____	H-9
	T ____ R ____	J-7
	T ____ R ____	
2. Property Controlling	S ____ T ____ R ____	
in Section	S ____ T ____ R ____	
3. Miscellaneous	S ____ T ____ R ____	
Property in Sec.	S ____ T ____ R ____	

Register of Deeds Stamp & File Number

4. Lot No. _____ , Recorded Plat _____
5. Private Claims _____

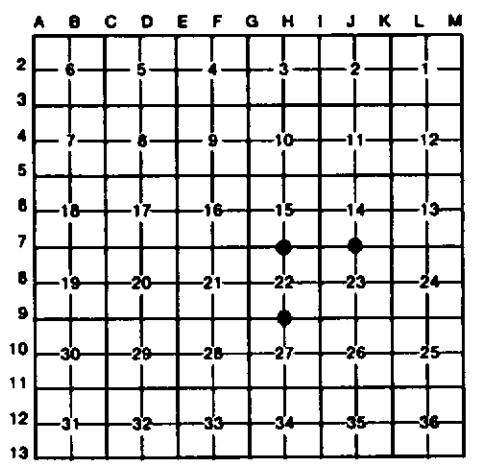

I, CARL F. ROSER, in a field survey on APRIL 18, 19 84, do hereby certify that under requirements of P.A. 74, Michigan P.A. of 1970, the corner points mentioned in lines 1 and 2 above were in conformance with regulations and rules therefore as required in the current manual of survey instructions of the United States Department of the Interior, Bureau of Land Management or by a decree of a Court of Law and/or that the corner points mentioned in lines 3, 4 and 5 above were in conformance with the rules of the Michigan Board of Land Surveyors or by a Decree of a Court of Law; established, re-established, monumented, re-monumented, recovered, found as expressed below:

NOTE: Not more than 4 corners, all in the same town and range, may be recorded on this certificate.

A. Description of original monument and accessories and/or subsequent restoration:

H-7 H-9 J-7

B. Description of corner evidence found and/or method applied in restoring or reestablishing corner:

H-7
FD OLD 1/2" ROD & PIECES OF BROKEN TILE AS NOTED BY CO SURVEYOR, A. O. TEMPLE IN 1892. TEMPLE'S NOTES SAY HE HAD ORIG GOVT HEM COR TREE (DEAD) HERE. COR IS IN APPROX CTR OF E-W GR RD., IS ON SPLIT E-W R.O.W. FN'S & IN LINE W/FN TO SOUTH.

H-9
FD CO SURVEYOR A.O. TEMPLE'S IR.ROD IN TILE AT OLD COR FN POST (FN'S E-W-N). TEMPLE HAD U.S.D.T. STUMP HERE IN 1892. TEMPLE'S PINE STUMP WITH (3) NOTCHES IS EAST, 55 LINKS.

J-7
FD OLD 1/2"X46" IR. ROD; BELIEVED TO BE BY CO SURVEYOR A.O. TEMPLE (1892) WHO CALLED FOR 4' ROD IN 3-12" TILES. WE COULD NOT LOCATE TILE'S BY DIGGING 4 1/2' DEEP. FD.OLD FN COR ON GRD,N 31' (FN'S E-W-N). COR FITS TWO WITS BY RLS, PAT SALISBURY, WHO USED THIS COR FOR CERT SURVEY,E1/2-SW1/4 OF SEC 14, LIBER 295, PG 538, JAN. 1972

C. Description of monument for corner and accessories established to perpetuate locating the position of the corner:

H-7
FD OLD 1/2" IR ROD & PIECES OF BROKEN TILE;RAISED UP W/1/2"X18" PIPE W/RLS CAP.

14" D CHERRY	N50°W	70.5'
16" D CHERRY	S65°E	79.9'
13" D CHERRY	S70°W	61.3'
SET CED POST W/LOC TAG	DUE S	33'
CTR OF 2 POLE W-S PIPELINE	EAST	14'

H-9
FD OLD 1/2" IR ROD IN TILE;NAILED LOC TAG ON COR FN POST.

3" R.PINE	N55°W	15.5'
18" R.OAK	N25°E	16.3'
20" W.OAK	S25°E	14.1'

J-7
FD OLD 1/2" X 46" IR ROD IN CTR GR RDS E-W-S.

7" SUG.MAPLE	N10°E	85.6'
5" MAPLE	S40°W	94.2'
P.POLE	N35°W	40.91'
SET CED POST W/LOC TAG	DUE N	33'

STATE OF MICHIGAN
CARL F. ROSER
LAND SURVEYOR
No. 12028
REGISTERED LAND SURVEYOR

Signed by Carl F. Roser 02-05-91 Date _____

Surveyor's Michigan License No. 12028

FORM APPROVED BY MICHIGAN STATE BOARD OF LAND SURVEYORS, JAN. 28, 1971
REVISED MAY 14, 1975
REVISED JAN., 1983