

FEB 25 1994

COMMISSION

LAND CORNER RECORDATION CERTIFICATE
Filing Requirement of Act 74, Mich. P.A. 1970

For corners in

Osceola
 (County)

Located In:

Corner Code #/

- 1. Public Land Survey T 19N R 9W A-9
 T R
 T R
 T R
- 2. Property Controlling S T R
 in Section S T R
- 3. Miscellaneous S T R
 Property in Sec. S T R
- 4. Lot No. _____, Recorded Plat _____
- 5. Private Claims _____

APPROVED LAND CORNER
P.A. 345 OF 1990
Osceola County

Matthew McClung
8 Dec 1993

Register of Deeds Stamp & File Number


	A	B	C	D	E	F	G	H	I	J	K	L	M
2	6		5		4		3		2		1		
3													
4	7		8		9		10		11		12		
5													
6	18		17		16		15		14		13		
7													
8	19		20		21		22		23		24		
9													
10	30		29		28		27		26		25		
11													
12	31		32		33		34		35		36		
13													

I, Matthew McClung, a field survey on December 4, 19 1993, do hereby certify that under requirements of P.A. 74, Michigan P.A. of 1970, the corner points mentioned in lines 1 and 2 above were in conformance with regulations and rules therefore as required in the current manual of survey instructions of the United States Department of the Interior, Bureau of Land Management or by a decree of a Court of Law and/or that the corner points mentioned in lines 3, 4 and 5 above were in conformance with the rules of the Michigan Board of Land Surveyors or by a Decree of a Court of Law; established, re-established, monumented, re-monumented, recovered, found as expressed below:

NOTE: Not more than 4 corners, all in the same town and range, may be recorded on this certificate.

A. Description of original monument and accessories and/or subsequent restoration:
 The original corner was set by deputy surveyor John Hodgson on Dec. 12, 1837. Set wood post 80.00 chains from the South.
 Hemlock 7" S37W 35 lks.
 Sugar 8" N66W 32 lks.
 From 1891 to 1904 approximately, Osceola County had a remonumentation program, in which surveyors Temple and Trumbull, did the work. For the most part, a 3" glazed tile filled with cinders from a forge, were placed at each government set corner in the township. There were supposed to be 3 tile per corner, placed atop of each other, (continued on back)

B. Description of corner evidence found and/or method applied in restoring or reestablishing corner:
 Found 1/2 rerod at surface. Found 1 1/4 square bolt head on 3/4" shaft and tile, at 17" below road surface. Set Osceola County Monument in center of tile 7" below road surface. Corner is in center of road intersection.

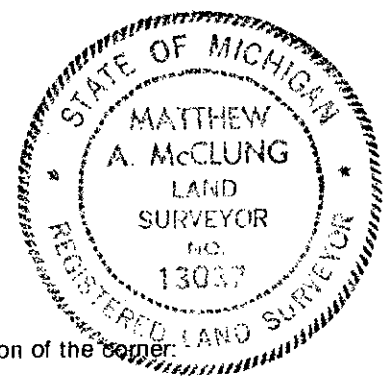

C. Description of monument for corner and accessories established to perpetuate locating the position of the corner.
 Corner M-9. Osceola County Monument, which is a 3" brass cap mounted on a 1" pipe 18" in length.
 24" W. Pine N52E 72.8 feet.
 20" W. Pine S52 E 48.4 feet.
 16" W. Pine S65E 98.0 feet.
 16" W. Pine S62W 50.65 feet.

Signed by Matthew McClung Date December 4, 1993
 Surveyor's Michigan License No. 13037

OSCEOLA COUNTY
REGISTER OF DEEDS

93 DEC 10 PM 2:50

Nancy Crawford

thereby making the corner 4 feet long. Sometimes a solid tile, with a cross in the top was used, and sometimes a 1/2" iron bars were added to the tile. Notes of the work were kept in ledgers, and given to the townships, and 5 of the townships have been recorded in the County records.

This corner is recorded in the Rose Lake Twp. Book, pages 6 & 7, stating tile corner, dated April 14, 1904. Witness is Elm 6" N65W 124 lks. In 1957 it looks to read Elm 24" N65W 81 feet.

PA. 132 certificate dated 16 Mar. 1988, by McClung.