

SURVEY & REMONUMENTATION

SEP 10 1998

LAND CORNER RECORDATION CERTIFICATE
Filing Requirement of Act 74, Mich. P.A. 1970

SECTION

For corners in Osceola (County) Located in: _____ Corner Code # _____

1. Public Land Survey T 19 R 9W B-6
 T _____ R _____
 T _____ R _____
 T _____ R _____

2. Property Controlling in Section S _____ T _____ R _____
 S _____ T _____ R _____

3. Miscellaneous Property in Sec. S _____ T _____ R _____
 S _____ T _____ R _____

4. Lot No. _____, Recorded Plat _____
 5. Private Claims _____

I, Matthew McClung in a field survey on 5-24, 1998 do hereby state that under requirements of P.A. 74, Michigan P.A. of 1970, the corner points mentioned in lines 1 and 2 above were in conformance with regulations and rules therefore as required in the current manual of survey instructions of the United States Department of the Interior, Bureau of Land Management or by a decree of a Court of Law and /or that the corner points mentioned in lines 3, 4 and 5 above were in conformance with the rules of the Michigan Board of Land Surveyors or by a Decree of a Court of Law, established, re-established, monumented, recovered, found as expressed below:

NOTE: Not more than 2 corners, all in the same town and range, may be recorded on this certificate.

A. Description of original monument and accessories and/or subsequent restoration:
 This corner was not set by original survey.

B. Description of corner evidence found and/or method applied in restoring or reestablishing corner:
 Set Osceola County Monument at intersection of One Quarter lines 3" below road surface.

C. Description of monument for corner and accessories established to perpetuate locating the position of the corner:
 Corner B-6. Osceola County Monument, which is a 3" brass cap mounted on a 1" pipe 18" in length.
 18" Box Elder S05W 39.03 feet.
 Power Pole S72W 125.05 feet.
 20" Maple N50W 50.70 feet.
 NE Corner of house S40W 73.25 feet.


OSCEOLA COUNTY REGISTER OF DEEDS
 98 JUL 23 PM 12:00
Matthew McClung

APPROVED LAND CORNER
 P.A. 345 OF 1998
 Osceola County

28 May 1998
Matthew M. McClung

Register of Deeds Stamp & File Number

	A	B	C	D	E	F	G	H	I	J	K	L	M
1													
2	6		5		4		3		2		1		
3													
4	7		8		9		10		11		12		
5													
6	16		17		16		15		14		13		
7													
8	19		20		21		22		23		24		
9													
10	30		29		28		27		26		25		
11													
12	31		32		33		34		35		36		
13													

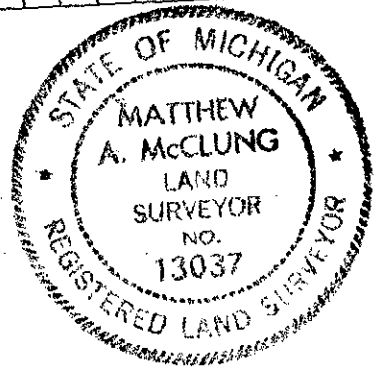

Signed by Matthew M. McClung
 Surveyor's Michigan License No. 13037

Date 23 July 1998