

# SURVEY & REMONUMENTATION

APR 25 1995

## LAND CORNER RECORDATION CERTIFICATE Filing Requirement of Act 74, Mich. P.A. 1970

For corners **COMMISSION**

<u>Osceola</u> <small>(County)</small>	Located In:	Corner Code #	
1. Public Land Survey	T <u>19</u> R <u>9W</u>	<u>B-7</u>	
	T _____ R _____	_____	
	T _____ R _____	_____	
	T _____ R _____	_____	
2. Property Controlling in Section	S _____ T _____ R _____	_____	
	S _____ T _____ R _____	_____	
3. Miscellaneous Property in Sec.	S _____ T _____ R _____	_____	
	S _____ T _____ R _____	_____	
4. Lot No. _____, Recorded Plat _____			
5. Private Claims _____			

APPROVED LAND CORNER  
P.A. 345 OF 1990  
Osceola County

*December 14, 1994*  
*Matthew McClung*

Register of Deeds Stamp & File Number

I, Matthew McClung, in a field survey on December 11, 1994 do hereby certify that under requirements of P.A. 74, Michigan P.A. of 1970, the corner points mentioned in lines 1 and 2 above were in conformance with regulations and rules therefore as required in the current manual of survey instructions of the United States Department of the Interior, Bureau of Land Management or by a decree of a Court of Law and/or that the corner points mentioned in lines 3, 4 and 5 above were in conformance with the rules of the Michigan Board of Land Surveyors or by a Decree of a Court of Law; established, re-established, monumented, re-monumented, recovered, found as expressed below:

	A	B	C	D	E	F	G	H	I	J	K	L	M
2	6	5	4	3	2	1							
3													
4	7	8	9	10	11	12							
5													
6	18	17	16	15	14	13							
7	•												
8	19	20	21	22	23	24							
9													
10	30	29	28	27	26	25							
11													
12	31	32	33	34	35	36							
13													

**NOTE: Not more than 4 corners, all in the same town and range, may be recorded on this certificate.**


**A. Description of original monument and accessories and/or subsequent restoration:**

The original corner was set by deputy surveyor Sylvester Sibley on July 7, 1838. Set wood post 36.5 chains from the West.  
Hemlock 7" N7W 7 lks.  
Sugar 12" S1E 19 lks.

From 1891 to 1904 approximately, Osceola County had a remonumentation program, in which surveyors Temple and Trumbull, did the work. For the most part, a 3" glazed tile filled with cinders from a forge, were placed at each government set corner in the township. There were supposed to be 3 tile per corner, placed atop of each other, (continued on back)

**B. Description of corner evidence found and/or method applied in restoring or reestablishing corner:**

Found 1 1/4" solid iron shaft @ 15 Mile Rd. surface. Dug finding clay tile chip & Pieces to 1.10' here. I found a 3" clay tile removed shaft from tile. Set Osceola County Monument into tile Set at 0.4 depth.

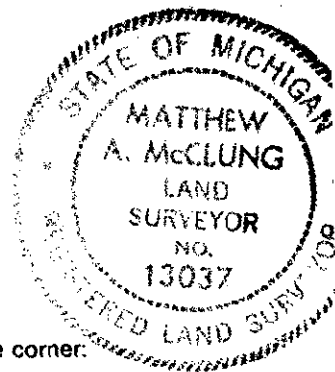

**C. Description of monument for corner and accessories established to perpetuate locating the position of the corner:**

Corner B-7 Osceola County Monument, which is a 3" brass cap mounted on a 1" pipe 18" in length.  
5" crabapple N50W 36.5 feet O.B.T.  
Power Pole N08W 74.4 feet  
1" Northern Pine N58E 47.4 feet  
12" Elm S85W 112.5 feet

APR 25 1995

Signed by Matthew McClung

Date December 11, 1994

Surveyor's Michigan License No. 13037

FORM APPROVED BY MICHIGAN STATE BOARD OF LAND SURVEYORS, JAN. 28, 1971  
REVISED MAY 14, 1975  
REVISED JAN., 1983

OSCEOLA COUNTY  
REGISTER OF DEEDS

94 DEC 16 PM 4:07

*Nancy Crawford*

thereby making the corner 4 feet long. Sometimes a solid tile, with a cross in the top was used, and sometimes a 1/2" iron bars were added to the tile. Notes of the work were kept in ledgers, and given to the townships, and 5 of the townships have been recorded in the County records.

there 1 LCRC Lib 2, Page 124 McClung

Act 132, Lib 485, Page 597, Lib 527 Page 91.

OSCEOLA COUNTY  
REGISTER OF DEEDS  
