

**SURVEY &
REMONUMENTATION**

DEC 16 1996

COMMISSION

LAND CORNER RECORDATION CERTIFICATE
Filing Requirement of Act 74, Mich. P.A. 1970

For corners in

<u>Osceola</u> (County)	Located In:	Corner Code #
1. Public Land Survey	T <u>19N</u> R <u>9W</u>	<u>C-11</u>
	T ___ R ___	_____
	T ___ R ___	_____
	T ___ R ___	_____
2. Property Controlling in Section	S ___ T ___ R ___	_____
	S ___ T ___ R ___	_____
3. Miscellaneous Property in Sec.	S ___ T ___ R ___	_____
	S ___ T ___ R ___	_____

APPROVED LAND CORNER
P.A. 345 OF 1990
Osceola County

Matthew McClung
7 Nov 1996

Register of Deeds Stamp & File Number

4. Lot No. _____, Recorded Plat _____
5. Private Claims _____

I, Matthew McClung in a field survey on 10-7, 19 96 do hereby state that under requirements of P.A. 74, Michigan P.A. of 1970, the corner points mentioned in lines 1 and 2 above were in conformance with regulations and rules therefore as required in the current manual of survey instructions of the United States Department of the Interior, Bureau of Land Management or by a decree of a Court of Law and /or that the corner points mentioned in lines 3, 4 and 5 above were in conformance with the rules of the Michigan Board of Land Surveyors or by a Decree of a Court of Law; established, re-established, monumented, recovered, found as expressed below:

NOTE: Not more than 2 corners, all in the same town and range, may be recorded on this certificate.

A	B	C	D	E	F	G	H	I	J	K	L	M
1												
2	6		5		4		3		2		1	
3												
4	7		8		9		10		11		12	
5												
6	18		17		16		15		14		13	
7												
8	19		20		21		22		23		24	
9												
10	30		29		28		27		26		25	
11												
12	31		32		33		34		35		36	
13												

A. Description of original monument and accessories and/or subsequent restoration:

The original corner was set by deputy surveyor Sylvester Sibley on July 7, 1838. Set wood post 40.00 chains from the South.
Tamarack 5" N25E 53 lks.
Willow 4" S17E 18 lks.


From 1891 to 1904 approximately, Osceola County had a remonumentation program, in which surveyors Temple and Trumbull, did the work. For the most part, a 3" glazed tile filled with cinders from a forge, were placed at each government set corner in the township. There were supposed to be 3 tile per corner, placed atop of each other, (continued on back)

B. Description of corner evidence found and/or method applied in restoring or reestablishing corner:

Found Osceola County Monument in centerline of East and West road, 1 foot East of centerline in North and South road 3" below surface. Excavated to 14" and found cement monument under top of Osceola County Monument. Present surface is filled approximately 4-5 feet from original surface.

C. Description of monument for corner and accessories established to perpetuate locating the position of the corner:

Corner C-11. Osceola County Monument, which is a 3" brass cap mounted on 1" pipe 18" in length.
5' Telephone Pole S48E 69.20 feet.
Telephone Pedestal S40W 56.25 feet.
N. End Culvert N56W 65.25 feet.
S. End Culvert S52W 63.60 feet.

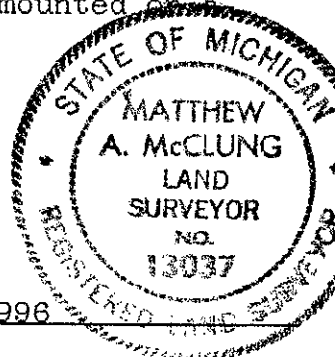

Signed by Matthew McClung
Surveyor's Michigan License No. 13037

Date October 7, 1996

OSCEOLA COUNTY
REGISTER OF DEEDS

96 NOV 26 PM 2:15

Nancy Crawford

thereby making the corner 4 feet long. Sometimes a solid tile, with a cross in the top was used, and sometimes a 1/2" iron bars were added to the tile. Notes of the work were kept in ledgers, and given to the townships, and 5 of the townships have been entered in the County Surveyors records.

I have shown 2 L.C.R.C.: Liber 1, Page 375; Liber 2, Page 331.

I have shown 1 PA. 132: Liber 326, Page 151.

Rose Lake Township book; Pages 14 and 15, Pages 28 and 29.

SURVEY &
PERMANENTMENTATION

DEC 16 1996

COMMISSION