

SURVEY & REMONUMENTATION

APR 25 1995

LAND CORNER RECORDATION CERTIFICATE Filing Requirement of Act 74, Mich. P.A. 1970

For corners in
Osceola
(County)

- | | | |
|---------------------------------------|----------------------------|-----------------------------|
| 1. Public Land Survey | T <u>19</u> N R <u>9</u> W | Corner Code #
<u>D-7</u> |
| | T _____ R _____ | _____ |
| | T _____ R _____ | _____ |
| | T _____ R _____ | _____ |
| 2. Property Controlling in Section | S _____ T _____ R _____ | _____ |
| | S _____ T _____ R _____ | _____ |
| 3. Miscellaneous Property in Sec. | S _____ T _____ R _____ | _____ |
| | S _____ T _____ R _____ | _____ |
| 4. Lot No. _____, Recorded Plat _____ | | |
| 5. Private Claims _____ | | |

APPROVED LAND CORNER
P.A. 345 OF 1990
Osceola County

December 14, 1994
Matthew A. McClung

Register of Deeds Stamp & File Number

Matthew McClung, in a field survey on December 11, 191994 do hereby certify that under requirements of P.A. 74, Michigan P.A. of 1970, the corner points mentioned in lines 1 and 2 above were in conformance with regulations and rules therefore as required in the current manual of survey instructions of the United States Department of the Interior, Bureau of Land Management or by a decree of a Court of Law and/or that the corner points mentioned in lines 3, 4 and 5 above were in conformance with the rules of the Michigan Board of Land Surveyors or by a Decree of a Court of Law; established, re-established, monumented, re-monumented, recovered, found as expressed below:

	A	B	C	D	E	F	G	H	I	J	K	L	M
2	6	5	4	3	2	1							
3													
4	7	8	9	10	11	12							
5													
6	18	17	16	15	14	13							
7		●											
8	19	20	21	22	23	24							
9													
10	30	29	28	27	26	25							
11													
12	31	32	33	34	35	36							
13													

NOTE: Not more than 4 corners, all in the same town and range, may be recorded on this certificate.


A. Description of original monument and accessories and/or subsequent restoration:

The original corner was set by deputy surveyor Sylvester Sibley on July 7, 1838. Set wood post 39.94 chains from the East Beech tree 6" for corner

From 1891 to 1904 approximately, Osceola County had a remonumentation program, in which surveyors Temple and Trumbull, did the work. For the most part, a 3" glazed tile filled with cinders from a forge, were placed at each government set corner in the township. There were supposed to be 3 tile per corner, placed atop of each other, (continued on back)

B. Description of corner evidence found and/or method applied in restoring or reestablishing corner:

Found 5/8" Iron & cap # 13037 as described on LCRC Broke asphalt away and set Osceola County Monument over to 2" depth. This corner is in a 6.0 ft. fill.

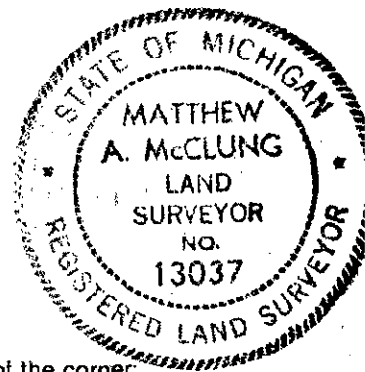

C. Description of monument for corner and accessories established to perpetuate locating the position of the corner:

Corner D-7 Osceola County Monument, which is a 3" brass cap mounted on a 1" pipe 18" in length.
 Face of riser box S35E 40.80 feet
 1" White Pine S65W 91.18 feet
 Easterly of two Utility poles N45°W 64.34'
 3" Apple N60E 94.29 feet

DEC 12 1994
MICHIGAN STATE BOARD OF LAND SURVEYORS

Signed by Matthew A. McClung

Date December 11, 1994

Surveyor's Michigan License No. 13037

FORM APPROVED BY MICHIGAN STATE BOARD OF LAND SURVEYORS, JAN. 28, 1971
REVISED MAY 14, 1975
REVISED JAN., 1983

OSCEOLA COUNTY
REGISTER OF DEEDS


94 DEC 16 PM 4:08

Nancy Crawford

thereby making the corner 4 feet long. Sometimes a solid tile, with a cross in the top was used, and sometimes a 1/2" iron bars were added to the tile. Notes of the work were kept in ledgers, and given to the townships, and 5 of the townships have been recorded in the County records.

There is 1 LCRC Lib 3 Page 11 Taylor

Act 132, Lib 535, Page 332.

 

OSCEOLA COUNTY
REGISTER OF DEEDS
LIBER A PAGE 261