

**SURVEY &  
REMONUMENTATION**

DEC 16 1996

COMMISSION

**LAND CORNER RECORDATION CERTIFICATE  
Filing Requirement of Act 74, Mich. P.A. 1970**

For corners in

Osceola  
(County)

Located in:

Corner Code #

- |                                       |   |             |
|---------------------------------------|---|-------------|
| 1. Public Land Survey                 | T <u>19N</u> R <u>RW</u>                  | D-10        |
|                                       | T <u>    </u> R <u>    </u>               | <u>    </u> |
|                                       | T <u>    </u> R <u>    </u>               | <u>    </u> |
|                                       | T <u>    </u> R <u>    </u>               | <u>    </u> |
| 2. Property Controlling<br>in Section | S <u>    </u> T <u>    </u> R <u>    </u> | <u>    </u> |
|                                       | S <u>    </u> T <u>    </u> R <u>    </u> | <u>    </u> |
| 3. Miscellaneous<br>Property in Sec.  | S <u>    </u> T <u>    </u> R <u>    </u> | <u>    </u> |
|                                       | S <u>    </u> T <u>    </u> R <u>    </u> | <u>    </u> |

APPROVED LAND CORNER  
P.A. 345 OF 1990  
Osceola County

*Matthew M. McClung*  
7 Nov 1996

Register of Deeds Stamp & File Number

4. Lot No. \_\_\_\_\_, Recorded Plat \_\_\_\_\_  
5. Private Claims \_\_\_\_\_

I, Matthew McClung, in a field survey on 10-7, 1996 do hereby state that under requirements of P.A. 74, Michigan P.A. of 1970, the corner points mentioned in lines 1 and 2 above were in conformance with regulations and rules therefore as required in the current manual of survey instructions of the United States Department of the Interior, Bureau of Land Management or by a decree of a Court of Law and /or that the corner points mentioned in lines 3, 4 and 5 above were in conformance with the rules of the Michigan Board of Land Surveyors or by a Decree of a Court of Law; established, re-established, monumented, recovered, found as expressed below:

NOTE: Not more than 2 corners, all in the same town and range, may be recorded on this certificate.

	A	B	C	D	E	F	G	H	I	J	K	L	M
1													
2	6		5		4		3		2		1		
3													
4	7		8		9		10		11		12		
5													
6	16		17		16		15		14		13		
7													
8	19		20		21		22		23		24		
9													
10	30		31		28		27		26		25		
11													
12	31		32		33		34		35		36		
13													

A. Description of original monument and accessories and/or subsequent restoration:  
No Government stake set.


I have shown 6 PA 132 certificates by McClung, Bankert and Cole.

I have shown 1 LCRC certificate by McClung.

*Gregory Campbell*  
95 NOV 26 PM 2:15  
OSCEOLA COUNTY  
REGISTER OF DEEDS

B. Description of corner evidence found and/or method applied in restoring or reestablishing corner:

Found Osceola County Monument at surface with top bent to North. Removed old monument and replaced with new Osceola County Monument 6" below surface.

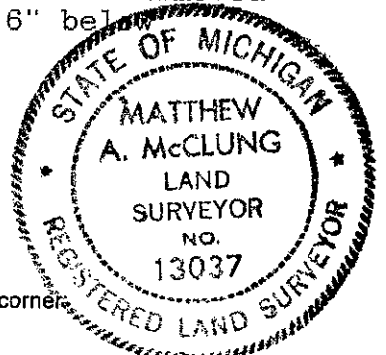

C. Description of monument for corner and accessories established to perpetuate locating the position of the corner:

Corner D-10. Osceola County Monument, which is a 3" brass cap mounted on a 1" pipe 18" in length.  
16" W. Pine S85W 58.76 feet (nail) O.B.T.  
28" W. Pine S28W 114.8 feet.  
Power Pole S10W 145.02 feet.  
Transmission Line Power Pole S23E 100.60 feet.

Signed by *Matthew M. McClung*  
Surveyor's Michigan License No. 13037

Date October 7, 1996