

SURVEY & REMONUMENTATION

DEC 13 2000

SECTION

LAND CORNER RECORDATION CERTIFICATE

FILING REQUIREMENT OF ACT 74, Mich. P.A. 1970

For corners in
Osceola

Located in: Corner Code#

1. Public Land Survey T 19 N R 9 W K-3
T R
T R
T R

2. Property Controlling S T R
in Section S T R

3. Miscellaneous S T R
Property in Sec. S T R

4. Lot No. Recorded Plat

5. Private Claims

OSCEOLA COUNTY
 REGISTER OF DEEDS
 00 OCT 11 AM 9:49
 Register of Deeds Stamp & File Number

	A	B	C	D	E	F	G	H	I	J	K	L	M
1													
2	6	5	4	3	2	1							
3													
4	7	8	9	10	11	12							
5													
6	18	17	16	15	14	13							
7													
8	19	20	21	22	23	24							
9													
10	30	29	28	27	26	25							
11													
12	31	32	33	34	35	36							
13													

I, Robert L. Wetherell, in a field survey on April 10, 2000, do hereby certify that under requirements of P.A. 74, Michigan P.A. of 1970, the corner points mentioned in lines 1 and 2 above were in conformance with regulations and rules therefore as required in the current manual of survey instructions of the United States Department of the Interior, Bureau of Land Management or by decree of a Court of Law and/or that the corner points mentioned in lines 3, 4, and 5 above were in conformance with the rules of the Michigan Board of Land Surveyors or by a Decree Of a Court of Law; established, re-established, monumented, re-monumented, recovered, found as expressed below:

K-3 - Section corner common to Sections 1, 2, 11 & 12, T19N, R9W

- A. Description of original monument and accessories and/or subsequent restoration:**
- | | | |
|--|-----------------------------------|---|
| <u>1838 - S. Sibley, G.L.O.</u> | <u>Undated Co. Sur Twp. Book</u> | <u>1988 - R.L. Wetherell, LS 24624</u> |
| #1 - 6" Sugar N42°E 11 Links | "Iron" | "Found Iron 3 1/2' below surface of blacktop road". |
| #2 - 8" Beech S17 1/2°W 30 Links | #5 - S.E. cor. Church N39°W 52.7' | Raised with 1/2" capped iron. |
| | #6 - Poplar S47 1/2°W 50.5' | #7 - 10" Apple N24°E 45.22' |
| <u>1892 - A.O. Temple, Co. Sur.</u> | | #5 - S.E. cor. Blk. Foundation N45°W 52.67' |
| Remonumentation of T19N, R9W | | #8 - N.W. Cor. Blk. Foundation N32°E 84.15' |
| "Original witnesses gone, identified by John Williams who was familiar with it's location. | | #9 - 14" Maple S70°W 90.0' |
| #3 - 3" Maple N14°E 191 Links | | |
| #4 - Dwelling House N39°W 119 Links | | |


B. Description of corner evidence found and/or method applied in restoring of reestablishing corner:
 I found the 1/2" Capped Iron I placed in 1988. Below the 1/2" Capped Iron (40" more or less) I found what I believe is a 1" solid iron rod. I was not able to dig deeper to remove the iron due to stones. It fits the bearing and distance to the Southeast corner of the Church as called for in the old township notes, so accepted as corner.

Condition of the accessories are as follows: #1 Gone, #2 Gone, #3 Gone, #4 Measured 79 feet to Southeast corner of old foundation (bearing did not fit), #5 Found in good condition, #6 Gone, #7 Found dead, #8 Found in good condition, #9 Found in good condition.

C. Description of monument for corner and accessories established to perpetuate locating the position of the corner:
 I replaced the 1/2" Capped Iron with a 1" x 18" Iron Pipe with Osceola County Remon Cap, and is accepted as a careful and faithful reestablishment of the position of the original corner.

- 8" R. Pine N61°E 62.05' (60d spike S.E. side)
- 14" Maple S70°W 90.0' (center of tree) #9
- S.E. Corner of Block Foundation N46°W 52.67' (#5)
- N.W. corner of Block Foundation S32°E 84.15' (#8)

APPROVED LAND CORNER
 P.A. 345 OF 1990
 Osceola County
R. L. W.
8-17-2000

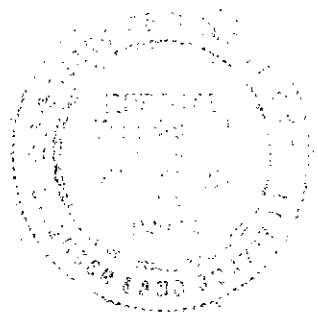

Signed by Robert L. Wetherell
 Surveyor's Michigan License No. 24624

Date August 22, 2000

FORM APPROVED BY MICHIGAN STATE BOARD OF LAND SURVEYORS. JAN. 28, 1971
 REVISED MAY 14, 1975
 REVISED JAN. 1983
 ADAPTED FOR WORD PROCESSING JANUARY, 1999