

**SURVEY & REMONUMENTATION**

DEC 13 2000

SECTION

**LAND CORNER RECORDATION CERTIFICATE**

FILING REQUIREMENT OF ACT 74, Mich. P.A. 1970

For corners in  
Osceola

Located in: Corner Code#

- 1. Public Land Survey T 19 N R 9 W M-4  
T R  
T R  
T R
- 2. Property Controlling in Section S T R  
S T R
- 3. Miscellaneous Property in Sec. S T R  
S T R
- 4. Lot No.        Recorded Plat
- 5. Private Claims

OSCEOLA COUNTY REGISTER OF DEEDS  
 00 MAY -5 PM 2:51  
*Mary Bradford*

Register of Deeds Stamp & File Number

	A	B	C	D	E	F	G	H	I	J	K	L	M
1													
2	6	5	4	3	2	1							
3													
4	7	8	9	10	11	12							
5													
6	18	17	16	15	14	13							
7													
8	19	20	21	22	23	24							
9													
10	30	29	28	27	26	25							
11													
12	31	32	33	34	35	36							

I, Robert L. Wetherell, in a field survey on April 10, 2000, do hereby certify that under requirements of P.A. 74, Michigan P.A. of 1970, the corner points mentioned in lines 1 and 2 above were in conformance with regulations and rules therefore as required in the current manual of survey instructions of the United States Department of the Interior, Bureau of Land Management or by decree of a Court of Law and/or that the corner points mentioned in lines 3, 4, and 5 above were in conformance with the rules of the Michigan Board of Land Surveyors or by a Decree Of a Court of Law; established, re-established, monumented, re-monumented, recovered, found as expressed below:

M-4 - E. 1/4 corner Sec. 12, T19N, R9W - W. 1/4 corner Sec. 7 T19N, R8W

**A. Description of original monument and accessories and/or subsequent restoration:**

1838 - J. Hodgson, G.L.O.

- #1 - 22" Hemlock S69°W 22 Links
- #2 - 16" Hemlock N65°W 39 Links

1892 - A.O. Temple, Co. Sur.

- "Found both U.S. B.T.'s".
- Set Clay Tile.
- #3 - 40" Pine Stump N88°E 174 Links
- #4 - 10" Beech N80°E 50 Links

1983 - M. McClung, LS 13037

- L.C.R.C. - Liber 02, Pg. 210
- Survey recorded Liber 404, Pg. 72
- Found Clay and Tile and Cinders.
- #5 - P. Pole S89°E 118.50'

1988 - R.L. Wetherell, LS 24624

- Found Tile and Iron.
- #5 - P. Pole S85°E 118.80'

1990 - M. McClung, LS 13037

- Survey recorded Liber 532, Pg. 786.
- #5 - P. Pole S89°E 118.5'

**B. Description of corner evidence found and/or method applied in restoring or reestablishing corner:**

I found a 1/2" Iron in 3" Clay Tile in line with old fence to East and 6 feet more or less West of the centerline of road North and South.

Condition of the accessories are as follows: #1 Gone, #2 Gone, #3 Gone, #4 Gone, #5 Found in good condition.

**C. Description of monument for corner and accessories established to perpetuate locating the position of the corner:**

I replaced the 1/2" Iron with a 1" x 18" Iron Pipe with Osceola County Remon Cap, and is accepted as a careful and faithful perpetuation of the position of the original corner.


- P. Pole N24°E 414.72' (P.K. Nail W. side)
- P. Pole S84°E 118.75' (60d spike S. side) #5
- 6" Cherry S20°E 64.04' (60d spike W. side)
- 8" R. Pine S02°E 309.14' (60d spike E. side)

**APPROVED LAND CORNER**

P.A. 245 OF 1990  
Osceola County

R. L. W.

4-20-2000

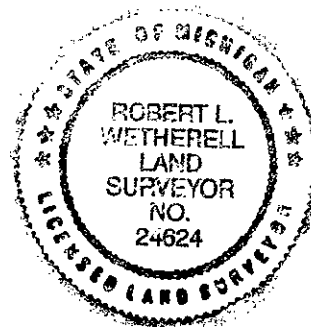

Signed by Robert L. Wetherell  
Surveyor's Michigan License No. 24624

Date April 25, 2000