

LAND CORNER RECORDATION CERTIFICATE
Filing Requirement of Act 74, Mich. P.A. 1970

For corners in
OSCEOLA
 (County)

Located In: _____ Corner Code ≠ _____

- | | | | | | |
|------------------------------------|---|------------|---|------------|------------------|
| 1. Public Land Survey | T | <u>20N</u> | R | <u>10W</u> | <u>J-1, K-2,</u> |
| | T | _____ | R | _____ | _____ |
| | T | _____ | R | _____ | _____ |
| | T | _____ | R | _____ | _____ |
| 2. Property Controlling in Section | S | _____ | T | _____ | _____ |
| | S | _____ | T | _____ | _____ |
| 3. Miscellaneous Property in Sec. | S | <u>2</u> | T | _____ | <u>#1296.1-E</u> |
| | S | _____ | T | _____ | <u>OF J-1</u> |

Register of Deeds Stamp & File Number

4. Lot No. _____, Recorded Plat _____
 5. Private Claims _____

	A	B	C	D	E	F	G	H	I	J	K	L	M
2	6	5	4	3	2	1							
3													
4	7	8	9	10	11	12							
5													
6	18	17	16	15	14	13							
7													
8	19	20	21	22	23	24							
9													
10	30	29	28	27	26	25							
11													
12	31	32	33	34	35	36							
13													

I, CARL F. ROSER, in a field survey on 2-28, 1991, do hereby certify that under requirements of P.A. 74, Michigan P.A. of 1970, the corner points mentioned in lines 1 and 2 above were in conformance with regulations and rules therefore as required in the current manual of survey instructions of the United States Department of the Interior, Bureau of Land Management or by a decree of a Court of Law and/or that the corner points mentioned in lines 3, 4 and 5 above were in conformance with the rules of the Michigan Board of Land Surveyors or by a Decree of a Court of Law; established, re-established, monumented, re-monumented, recovered, found as expressed below:

NOTE: Not more than 4 corners, all in the same town and range, may be recorded on this certificate.


- A. Description of original monument and accessories and/or subsequent restoration:
- | | | |
|------------|------------|------------------|
| <u>J-1</u> | <u>K-2</u> | <u>#1296.1-E</u> |
| | | <u>OF J-1</u> |

- B. Description of corner evidence found and/or method applied in restoring or reestablishing corner:

<u>J-1</u>	<u>K-2</u>	<u>#1296.1-E of J-1</u>
ESTABLISHED N1/4 COR OF SEC 2 MID-WAY BETWEEN NE & NW CORN OF S-2 AND ON LINE BET SW & S1/4 COR OF SEC 36 (T21N-R10W). BNR NON EQUALS ALUMINUM CAP ON 1" x 8' GALV PIPE (PUSHED IN).	FD 1/4" x 1" IR AS RECOVERED BY NSHD IN 1963. OLD N-S FN REMAINS ARE 4'-E.	DROVE 1" PIPE FOR THE NW COR OF GOVT LOT 1, PER STANDARD BLN INSTRUCTIONS.

- C. Description of monument for corner and accessories established to perpetuate locating the position of the corner:

<u>J-1</u>	<u>K-2</u>	<u>#1296.1-E of J-1</u>
SET BNR NON & CED POST.	FD 1/4" x 1" IRON; ADDED BNR NON & CEDAR POST.	DROVE 1" x 10-1/2' GALV PIPE W/RLS CAP IN COUPLING. SET CED POST W/LOC TAG.
6" CEDAR N40°W 16.9'	11" W. PINE N25°E 23.30'	7" DEAD TAMARACK
7" CEDAR N60°E 9.3'	#13" MAPLE S80°E 50.43'	STUB N28°W 12.0'
8" CEDAR S40°E 18.7'	14" W. PINE S40°E 36.95'	5" MAPLE S50°W 244.0'
8" CEDAR S45°W 17.2'	▲ W. PINE STP S35°E 36.41'	
SW SEC 36 T21N R10W S89°41'W 381.12	8" W. PINE S55°W 21.41'	
	‡ = NSHD 1963 MIT.	
	▲ = FRANK McCLUNG 1915 & NSHD 1963 MIT.	

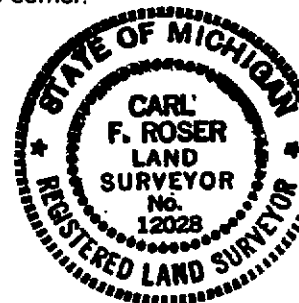

Signed by Carl F. Roser 03-16-91 Date _____
 Surveyor's Michigan License No. 12028