LAND CORNER RECORDATION CERTIFICATE

Filing Requirement of Act 74, Mich. P.A. 1970

For corners in OSCEOLA (County)

	Located In:		Corner Code ##
1. Public Land Survey	T 20N	R 10W	G-2, H-1,
	T	R	I-1
	T	R	
	T	R	
2. Property Controlling	S T	R	
in Section	S T	R	
3. Miscellaneous	S 3 T	R	*NW COR
Property in Sec.	S T	R	G. L. 8

Register of Deeds Stamp & File Number

4. Lot No. _____ , Recorded Plat _____
5. Private Claims _____

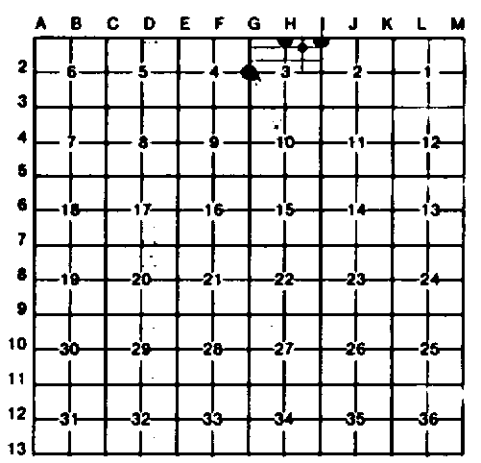

I, CARL F. ROSER, in a field survey on 2-28, 19 91, do hereby certify that under requirements of P.A. 74, Michigan P.A. of 1970, the corner points mentioned in lines 1 and 2 above were in conformance with regulations and rules therefore as required in the current manual of survey instructions of the United States Department of the Interior, Bureau of Land Management or by a decree of a Court of Law and/or that the corner points mentioned in lines 3, 4 and 5 above were in conformance with the rules of the Michigan Board of Land Surveyors or by a Decree of a Court of Law; established, re-established, monumented, re-monumented, recovered, found as expressed below:

NOTE: Not more than 4 corners, all in the same town and range, may be recorded on this certificate.

A. Description of original monument and accessories and/or subsequent restoration:

G-2 H-1 I-1 NW COR GL8

B. Description of corner evidence found and/or method applied in restoring or reestablishing corner:

G-2	H-1	I-1	*NW COR GL8
FD 1-1/2" PIPE & STONE FOR N 1/4 COR SEC 3. PIPE IS 5' SOUTH OF GRAVEL RD INTER (N-S-E-W). COR FITS RLS J. ERICKSON 1977 WITS.	ESTABLISHED N 1/4 COR G-3 AT INTER OF LINE BETW FD S1/4 G-35 & SW COR G-35 (21N-10W) AND PROJECTION NLY OF FN LINE ON N1/2 OF N-S 1/4 LINE G-3 (FN MAYBE RESULT OF F. McCLUNG 1904 SUR). COR IS 1'± S OF CTR E-W B. TOP RD.	RESTORED SEC COR COMM TO SEC'S 2 & 3 (T20N-R10W), ON MICH 2ND CORR LINE; AT RECORD 1904 FRANK McCLUNG DISTANCE EAST OF SW COR OF SEC 35 (T21N-R10W), 3090 FT., GLO = 46.74 CH = 3084.6', AND ON LINE BETWEEN S1/4 COR & SE COR OF SEC 35 (T21N-R10W). FITS 1904 SURVEY & SEC SUB'N OF SEC 3 (T20N-R10W) BY RLS, FRANK McCLUNG.	FD NARROW GAUGE RR IR (VERTICAL) AS ESTAB FOR NW COR OF GOVT LOT 8 OF SEC 3 IN 1904 SEC. SUBN BY FRANK McCLUNG, RLS (NOW DECEASED). COR FALLS NEAR W/BOTTOM EDGE OF 25'± WD FLAT SPRING DRAINAGE FROM NORTH. FENCE REMAINS ±3' (ALL DOWN) S & E.

C. Description of monument for corner and accessories established to perpetuate locating the position of the corner:

G-2	H-1	I-1	*NW COR GL8
FD OLD 1-1/2" PIPE W/COUPLING & STONE; ADDED 5/8"x 34" RE-ROD W/RLS CAP.	DROVE 5/8"x 17" RE-ROD W/RLS CAP.	DROVE 5/8"x 34" RE-ROD W/RLS CAP.	FD NARROW GAUGE RR IR AND SET SQ TOP 6" CED POST.
7" TAMARACK N35°E 122.24'	5" R PINE N20°W 58.02'	18" W PINE N30°W 59.26'	15" CEDAR N70°E 22.39'
*POWER POLE S45°E 84.13'	POWER POLE N65°E 119.10'	13" W PINE N40°E 61.59'	8" WILD APPLE S25°E 23.62'
*24" SPRUCE S35°W 95.05'	11" B CHERRY S15°E 102.17'	15" W PINE S40°W 89.73'	18" W BIRCH S45°W 31.19'
*TOP CTR METAL BELL TEL RISER.	DROVE 5/8"x 34" RE-ROD W/RLS CAP. & SET CEDAR POST	SET CEDAR POST	
LEANING S S62°W 44.9'	W/ LOC TAG S01°0'E 33.00'	W/LOC TAG DUE E 33'	
	SW SEC 35	S 1/3 SEC 35	
	T21N R10W S88°49'W 499.56'	T21N-R10W S89°05'W 439.47'	

Signed by Carl F. Roser 03-16-91 Date _____

Surveyor's Michigan License No. 12028

STATE OF MICHIGAN CARL F. ROSER LAND SURVEYOR No. 12028 REGISTERED LAND SURVEYOR

FORM APPROVED BY MICHIGAN STATE BOARD OF LAND SURVEYORS, JAN. 28, 1971
REVISED MAY 14, 1975
REVISED JAN., 1983