LAND CORNER RECORDATION CERTIFICATE

Filing Requirement of Act 74, Mich. P.A. 1970

For corners in
OSCEOLA
(County)

	Located In:	Corner Code ##
1. Public Land Survey	T 20N R 10W	G-3, H-2,
	T ___ R ___	H-3, I-3
	T ___ R ___	
	T ___ R ___	
2. Property Controlling	S ___ T ___ R ___	
in Section	S ___ T ___ R ___	
3. Miscellaneous	S ___ T ___ R ___	
Property in Sec.	S ___ T ___ R ___	

Register of Deeds Stamp & File Number

4. Lot No. _____ , Recorded Plat _____
5. Private Claims _____

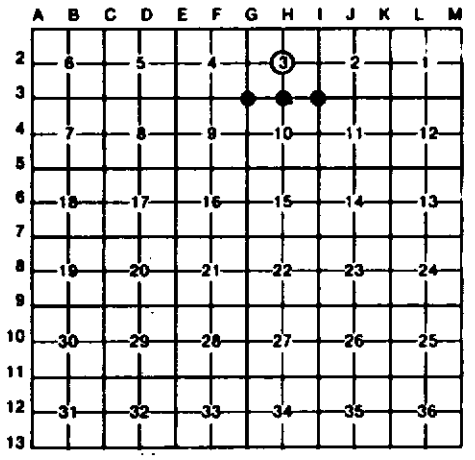

I, CARL F. ROSER, in a field survey on 2-28, 19 91, do hereby certify that under requirements of P.A. 74, Michigan P.A. of 1970, the corner points mentioned in lines 1 and 2 above were in conformance with regulations and rules therefore as required in the current manual of survey instructions of the United States Department of the Interior, Bureau of Land Management or by a decree of a Court of Law and/or that the corner points mentioned in lines 3, 4 and 5 above were in conformance with the rules of the Michigan Board of Land Surveyors or by a Decree of a Court of Law; established, re-established, monumented, re-monumented, recovered, found as expressed below:

NOTE: Not more than 4 corners, all in the same town and range, may be recorded on this certificate.

A. Description of original monument and accessories and/or subsequent restoration:

G-3 H-2 H-3 I-3

STATE OF MICHIGAN
CARL F. ROSER
LAND SURVEYOR
No. 12028
REGISTERED LAND SURVEYOR

B. Description of corner evidence found and/or method applied in restoring or reestablishing corner:

G-3
FD OSCEOLA CO MON FOR SW COR SEC 3. COR FITS J E ERICKSON, RLS, WITS AND FALLS 3' N OF GRAVEL RD INTER N-S-E-W.

H-2
FD 1" PIPE FOR CTR SEC 3 AS CALLED FOR IN F.McCLUNGS 1904 SURVEY (PIPE FITS OCCUPANCY AND F.McCLUNG SURVEY DATA VERY REASONABLE). PIPE IS IN CTR E-W GRAVEL RD AND IN APPROX LINE W/OLD DOWN FNS N & S.

H-3
REESTABLISHED S1/4 COR S-3 ON LINE & DOUBLE DISTANCE ACROSS FD SW & W1/8 COR ON S.LINE SEC 3. COR IS IN LINE W/FN N & 33' SO. OF OLD ROW FN WEST & 28'N OF NEWER ROW FN WEST. CTR GRV RD IS 5'± NORTH.

I-3
FD 5/8" RE-ROD IN MON BOX FOR SW COR OF SEC 2, 4'W OF CTR N-S B TOP & IN APPROX LINE W/CTR OF GRAVEL RD E & W. COR FITS MSHD DATA TO EAST.

C. Description of monument for corner and accessories established to perpetuate locating the position of the corner:

G-3
FD OSCEOLA CO MON.

#14" MAPLE	N60°W	64.46'
#POWER POLE	N65°E	71.42'
#19" S.MAPLE	S40°W	53.79'
3" B.CHERRY	S25°E	73.78'

H-2
FD OLD 1" PIPE.

31" R OAK	N30°E	54.98'
OLD FN COR	S03°W	34.88'
POWER POLE	S60°E	113.40'
TREATED FN POST	N40°W	38.43'

H-3
DROVE 5/8"x 34" RE-ROD W/RLS CAP.

9" MAPLE IN CLUMP 5	N40°W	47.00'
3" MAPLE	N15°E	41.25'
8" CEDAR	N50°E	72.53'
5" MAPLE	S10°W	51.31'

I-3
FD 5/8" RE-ROD IN MON BOX. TOP CTR METAL BELL

TEL RISER	N50°W	37.8'
2" W BIRCH IN CLUMP 3	N45°E	92.76'
POWER POLE	S55°E	67.31'
2" TW.MAPLE	S37°W	72.70'
CTR N-S BIT RD	DUE E	4'

= J.ERICKSON, LS WIT.

Signed by Carl F. Roser 03-16-91 Date _____

Surveyor's Michigan License No. 12028

FORM APPROVED BY MICHIGAN STATE BOARD OF LAND SURVEYORS, JAN. 28, 1971
REVISED MAY 14, 1975
REVISED JAN., 1983