

FEB 4 2000

LAND CORNER RECORDATION CERTIFICATE

FILING REQUIREMENT OF ACT 74, Mich. P.A. 1970

SECTION

For corners in
Osceola

Located in: Corner Code#

- | | | | | | |
|---------------------------------------|---|------|---|------|-----|
| 1. Public Land Survey | T | 19 N | R | 10 W | A-4 |
| | T | | R | | |
| | T | | R | | |
| | T | | R | | |
| 2. Property Controlling
in Section | S | T | R | | |
| | S | T | R | | |
| 3. Miscellaneous
Property in Sec. | S | T | R | | |
| | S | T | R | | |
| 4. Lot No. _____ Recorded Plat _____ | | | | | |
| 5. Private Claims _____ | | | | | |

Yvonne Campbell

99 DEC 23 PM 4:22

OSCEOLA COUNTY
REGISTER OF DEEDS

Register of Deeds Stamp & File Number

I, Robert L. Wetherell, in a field survey on November 18, 1999, do hereby certify that under requirements of P.A. 74, Michigan P.A. of 1970, the corner points mentioned in lines 1 and 2 above were in conformance with regulations and rules therefore as required in the current manual of survey instructions of the United States Department of the Interior, Bureau of Land Management or by decree of a Court of Law and/or that the corner points mentioned in lines 3, 4, and 5 above were in conformance with the rules of the Michigan Board of Land Surveyors or by a Decree Of a Court of Law; established, re-established, monumented, re-monumented, recovered, found as expressed below:

	A	B	C	D	E	F	G	H	I	J	K	L	M
1													
2	6	5	4	3	2	1							
3													
4	7	8	9	10	11	12							
5													
6	18	17	16	15	14	13							
7													
8	19	20	21	22	23	24							
9													
10	30	29	28	27	26	25							
11													
12	31	32	33	34	35	36							
13													

E. ¼ Corner Section 7, T19N, R10W, Osceola Co., Mi.

A. Description of original monument and accessories and/or subsequent restoration:

1838 - S. Sibley, G.L.O.

- #1 - 7" Birch S50°W 20 Links
- #2 - 10" Beech N84°W 7 Links

1891 - 1904 - Temple/Trumbull/June

The Township of Leroy (T19N, R10W)
Was remonumented with 3" Clay Tiles.

1919 - Frank McClung., Co. Sur.

- "Tile & Rod"
- #3 - T.P. S64°W 40'
- #4 - T.P. S40°E 25'

1987 - Clinton E. Cole, LS 17615

- Found ½" Rod in Tile
- #5 - 14" R. Pine N57°E 64.04'
- #6 - 16" W. Pine S38°E 73.12'
- #7 - 6" R. Pine S63°W 81.50'

1998 - R.L. Wetherell, LS 24624

- L.C.R.C. - Liber 04, Pg. 149, (Lake Co.)
- Ratified by Lake Co. Remon 10/27/98
- #8 - Fence Post S77°E 26.98'
- #5 - 18" R. Pine N58°E 63.75'
- #9 - Power Pole S63°W 90.91'
- #10 - 17" W. Pine S44°E 117.40'
- #11 - 5" Tw. Cherry N31°W 43.47'

B. Description of corner evidence found and/or method applied in restoring of reestablishing corner:

I found a ¾" x 24" re-bar with Lake County remon Cap in a 3" glazed tile at the intersection of roads West and South.

Condition of the accessories are as follows: #1 Gone, #2 Gone, #3 Gone, #4 Gone, #5 Found in good condition, #5 Found in poor condition, #6 Found in poor condition, #7 Gone.


C. Description of monument for corner and accessories established to perpetuate locating the position of the corner:

I accepted the ¾" x 24" re-bar with Lake County Brass Cap inside the 3" tile, and is accepted as a careful and faithful reestablishment of the position of the original corner.

- Fence Post S77°E 26.98' (60d spike in S. side) #8
- 18" R. Pine N58°E 63.75' (60d spike in S. side) #5
- Power Pole s63°W 90.91' (mag. Nail in S. side) 39
- 17" W. Pine S44°E 117.40' (60d spike in N.E. side) #10
- 5" Tw. Cherry N31°W 43.47' (60d spike in S.W. side) #11

Signed by Robert L. Wetherell
Surveyor's Michigan License No. 24624

Date 12/16/99

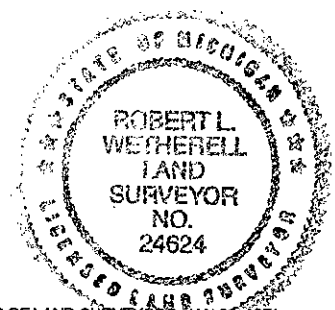

APPROVED LAND CORNER
P.A. 305 OF 1990
Osceola County

12/9/99
R. L. W.

FORM APPROVED BY MICHIGAN STATE BOARD OF LAND SURVEYORS, JAN 26, 1971
REVISED MAY 14, 1975
REVISED JAN., 1983
ADAPTED FOR WORD PROCESSING JANUARY, 1999