

FEB 4 2000

LAND CORNER RECORDATION CERTIFICATE

FILING REQUIREMENT OF ACT 74, Mich. P.A. 1970

SECTION

For corners in
Osceola _____ Located in: Corner Code#

1. Public Land Survey T 19N R 10W A-10
 T R
 T R
 T R

2. Property Controlling S T R
 in Section S T R

3. Miscellaneous S T R
 Property in Sec. S T R

4. Lot No. _____ Recorded Plat _____

5. Private Claims _____

OSCEOLA COUNTY
REGISTER OF DEEDS
99 DEC 23 PM 4:22
Henry C. Wetherell

Register of Deeds Stamp & File Number

I, Robert L. Wetherell, in a field survey on December 2, 1999, do hereby certify that under requirements of P.A. 74, Michigan P.A. of 1970, the corner points mentioned in lines 1 and 2 above were in conformance with regulations and rules therefore as required in the current manual of survey instructions of the United States Department of the Interior, Bureau of Land Management or by decree of a Court of Law and/or that the corner points mentioned in lines 3, 4, and 5 above were in conformance with the rules of the Michigan Board of Land Surveyors or by a Decree Of a Court of Law, established, re-established, monumented, re-monumented, recovered, found as expressed below:

	A	B	C	D	E	F	G	H	I	J	K	L	M
1													
2	6	5	4	3	2	1							
3													
4	7	8	9	10	11	12							
5													
6	18	17	16	15	14	13							
7													
8	19	20	21	22	23	24							
9													
10	30	29	28	27	26	25							
11													
12	31	32	33	34	35	36							
13													

M-10 - W. 1/4 Corner Section 30, T19N, R10W

A. Description of original monument and accessories and/or subsequent restoration:

- | | | |
|---|---|--|
| 1837 - J. Hodgson, G.L.O.
#1 - 7" Beech S49°W 13 Links
#2 - 7" Beech N76°W 42 Links | 1954 - L. Slater (M.S.H.D.)
1/2" Rod in Vit. Tile
#5 - 5" Maple N67°W 37.16'
#4 - 36" hemlock S46°W 59.98'
#6 - P. Pole S84°E 49.65' | 1998 - P. Trinklein, LS 43072
Found 3/8" Bolt in 1/4" Pipe
#8 - Found B & C #16923 - S82°E 33.06'
#6 - Utility Pole S73°E 51.00'
#5 - 21" Maple N60°W 37.36'
#9 - 17" Maple S52°W 38.40' |
| 1891 - 1904 - A. Temple/F. Trumbull
Remonumentation of T19N R10W
Set 3" Clay Tiles | 1971 - P. Salisbury, LS 13594
#4 - 40" Pine S45°W 59.49'
#5 - 14" Maple N70°W 37.17'
#6 - P. Pole S85°E 49.60' | 1999 - R.L. Wetherell, LS 24624
L.C.R.C. - Liber 04, Pg. 210, (Lake Co.)
Ratified by Lake Co. Remon 7/20/1999
#9 - 14" Maple S52°W 38.28'
#5 - 18" Maple N60°W 37.38'
#6 - Utility Pole S73°E 51.00'
#10 - 12" R. Pine N59°E 51.04' |
| 1922 - Osceola Co. Sur. Records
"Tile & Rod"
#3 - Tri-Maple NE 106.4'
#4 - Hemlock SW 59' | 1987 - Henry Muler, LS 25862
L.C.R.C. - L. 03, Pg. 048
Found 1/2" Rod in Tile.
#6 - Face of P. Pole S84°E 49.48'
#5 - 13" Maple N67°W 37.40'
#7 - Fence Post N88°E 33.73'
#3 - 40" Maple N20°E 107.75' | |

B. Description of corner evidence found and/or method applied in restoring of reestablishing corner:

I found a 3/4" x 24" rebar with Lake County Remon Cap. Corner is in the centerline of road North and South and in line with old fence to East.

Condition of the accessories are as follows: #1 Gone, #2 Gone, #3 Found in good condition, #4 Gone, #5 Found in good condition, #6 Replaced, #7 Gone, #8 Found in good condition, #9 Found in good condition, #10 Found in good condition.


C. Description of monument for corner and accessories established to perpetuate locating the position of the corner:

I replaced the 3/8" bolt with a 3/4" x 24" re-bar with Lake County Remon Cap, and is accepted as a careful and faithful re-establishment of the position of the original corner.

14" Maple S52°W 38.28' (Nail in S. side) #9
 18" Maple N60°W 37.38' (Nail in N. side) #5
 Utility Pole S73°E 51.00' (P.K. Nail in N. side) #6
 12" R. Pine N59°E 51.04' (60d spike in N. side) #10

Signed by Robert L. Wetherell
 Surveyor's Michigan License No. 24624

Date 12/16/99

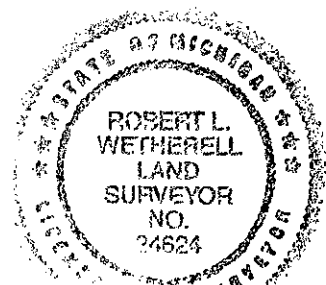

APPROVED LAND CORNER
 P.A. 345 OF 1990
 Osceola County

12/9/99
R.L.W.

FORM APPROVED BY MICHIGAN STATE BOARD OF LAND SURVEYORS, JAN. 28, 1971
 REVISED MAY 14, 1975
 REVISED JAN., 1983
 ADAPTED FOR WORD PROCESSING JANUARY, 1999