

RF

FEB 4 2000

LAND CORNER RECORDATION CERTIFICATE

FILING REQUIREMENT OF ACT 74, Mich. P.A. 1970

SECTION

For corners in Osceola	Located in:	Corner Code#
1. Public Land Survey	T 19N 10W	B-1
	T R	
	T R	
	T R	
2. Property Controlling s in Section	T R	
	S T R	
3. Miscellaneous Property in Sec.	S T R	
	S T R	
4. Lot No. _____ Recorded Plat		
5. Private Claims		

OSCEOLA COUNTY
 REGISTER OF DEEDS
 99 NOV 19 PM 12:10
Nancy Campbell
 Register of Deeds Stamp & File Number

	A	B	C	D	E	F	G	H	I	J	K	L	M
1													
2	6	5	4	3	2	1							
3													
4	7	8	9	10	11	12							
5													
6	18	17	16	15	14	13							
7													
8	19	20	21	22	23	24							
9													
10	30	29	28	27	26	25							
11													
12	31	32	33	34	35	36							
13													

I, Robert L. Wetherell, in a field survey on October 1 1999, do hereby certify that under requirements of P.A. 74, Michigan P.A. of 1970, the corner points mentioned in lines 1 and 2 above were in conformance with regulations and rules therefore as required in the current manual of survey instructions of the United States Department of the Interior, Bureau of Land Management or by decree of a Court of Law and/or that the corner points mentioned in lines 3, 4, and 5 above were in conformance with the rules of the Michigan Board of Land Surveyors or by a Decree Of a Court of Law; established, re-established, monumented, re-monumented, recovered, found as expressed below:

NOTE: ONLY ONE CORNER MAY BE RECORDED ON THIS CERTIFICATE.

N ¼ Corner of Section 6, T19N, R10W
 This Corner is common to the S ¼ Sec 31, T20N, R10W

- A. Description of original monument and accessories and/or subsequent restoration:**
- | | | |
|---|----------------------------------------------------------------------------------------------|---|
| <u>1838 S. Sibley</u>
#1-24" Beech B53E 8 Lk.
#2- 8" Beech N31W 29Lk. | <u>1891-1904 A. Temple F. Trumbull</u>
Remonumentation of T19N, R10W
Set 3" Clay Tile | <u>1994-1998 Schripsema LS 24617</u>
Fd. Clay Tile & 3/8" rod
#3- 10" Elm N78W 160.40'
#4- 20" Dbl. Maple N21W 38.29'
#5- 14" Aspen S74E 179.91' |
| <u>1998 M. McClung LS 13037</u>
Unrecorded Survey
Fd. 3/8" Rod & Tile
Set Osceola Co. Monument
#6- 5" R. Pine N5E 24.78'
#4- 12" Maple N26W 38.4'
#8- 7" Maple N60W 67.3'
#9- 4" R. Pine N82E 58.4' | <u>1968 G. Blass LS 5489</u>
Plow Point
12" Maple N12W 71.35'
14" Maple N42W 87.00' | |

B. Description of corner evidence found and/or method applied in restoring or reestablishing corner:


I found an Osceola County Monument by McClung in the intersection of fences North, South, East and West. I did not recover the plow point that Blass had in 1968.

Condition of the accessories are as follow: #1 Gone, #2 Gone, #3 Found in good condition, #4 Gone, #5 Gone #6 Found in good condition, #8 Found in good condition and #9 Found in good condition.

C. Description of monument for corner and accessories established to perpetuate locating the position of the corner:

I accept the Osceola County Monument (1 ½" pipe with an Osceola County Remon Cap) as a substantial marker of the corner and is accepted as a careful and faithful reestablishment of the position of the original corner.

5" R. Pine N5E 24.60' (Nail on W. Side) - #6
 12" Maple N26W 38.30' (Nail on W. Side) - #4
 7" Maple N60W 67.30' (Nail on S. Side) - #8
 4" R. Pine N82E 58.35' (Nail on W. Side) - #9

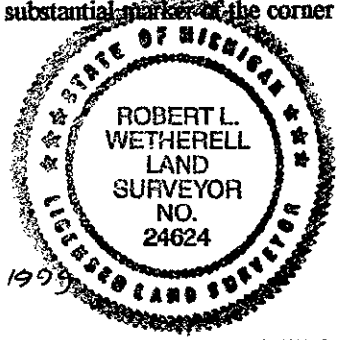

Signed by Robert L. Wetherell
 Surveyor's Michigan License No. 24624

Date Nov. 9, 1999

FORM APPROVED BY MICHIGAN STATE BOARD OF LAND SURVEYORS, JAN 28, 1971
 REVISED MAY 14, 1975
 REVISED JAN., 1983

APPROVED LAND CORNER
 P.A. 345 OF 1990
 Osceola County
10-21-99
R L W.