

SURVEY & REMONUMENTATION

DEC 13 2000

SECTION

LAND CORNER RECORDATION CERTIFICATE
 FILING REQUIREMENT OF ACT 74, Mich. P.A. 1970

For corners in Osceola Located in: Corner Code#

1. Public Land Survey T 19 N R 10 W B-5
 T R
 T R
 T R

2. Property Controlling in Section S T R
 S T R

3. Miscellaneous Property in Sec. S T R
 S T R

4. Lot No. _____ Recorded Plat _____

5. Private Claims _____

Francis Crawford
 OSCEOLA COUNTY
 REGISTER OF DEEDS
 00 MAY -5 PM 2:51

Register of Deeds Stamp & File Number

	A	B	C	D	E	F	G	H	I	J	K	L	M
1													
2	6	5	4	3	2	1							
3													
4	7	8	9	10	11	12							
5	•												
6	18	17	16	15	14	13							
7													
8	19	20	21	22	23	24							
9													
10	30	29	28	27	26	25							
11													
12	31	32	33	34	35	36							
13													

I, Robert L. Wetherell, in a field survey on April 5, 2000, do hereby certify that under requirements of P.A. 74, Michigan P.A. of 1970, the corner points mentioned in lines 1 and 2 above were in conformance with regulations and rules therefore as required in the current manual of survey instructions of the United States Department of the Interior, Bureau of Land Management or by decree of a Court of Law and/or that the corner points mentioned in lines 3, 4, and 5 above were in conformance with the rules of the Michigan Board of Land Surveyors or by a Decree Of a Court of Law; established, re-established, monumented, re-monumented, recovered, found as expressed below:

B-5 - 1/4 Corner common to Sections 7 & 18, T19N, R10W

A. Description of original monument and accessories and/or subsequent restoration:

1838 - S. Sibley, G.L.O.

#1 - 7" Beech N78°E 12 Links
 #2 - 4" Beech S38°E 14 Links

1919 - F. McClung, Co. Sur.

Railroad Rail - Tile & Rod.
 #3 - Post N2 1/2°W 29.5'
 #4 - Post South 23.5'

1997 - R.L. Wetherell, LS 24624

"Found a 1" Pipe over top of Tile".
 No accessories given.

1891-1904 - Temple Trumbull

Remonumentation T19N, R10W
 Set 3" Clay Tiles.

B. Description of corner evidence found and/or method applied in restoring of reestablishing corner:

I found a 1" pipe over top of a 3" Tile with cinders. Next to the Tile I found a railroad rail and old wood stake. Corner is in the centerline of East and West road, in line with fence to the South.

Condition of the accessories are as follows: #1 Gone, #2 Gone, #3 Gone, #4 Gone.


C. Description of monument for corner and accessories established to perpetuate locating the position of the corner:

I replaced the 1" Pipe with a 1" x 18" Pipe with Osceola County Remon Cap, and is accepted as a careful and faithful reestablishment of the position of the original corner.

- 22" W. Pine N54°W 69.85' (60d spike S. side)
- 9" W. Pine S69°W 57.84' (60d spike N.W. side)
- 12" R. Pine S27°E 40.88' (60d spike N.E. side)
- 16" R. Pine N39°E 127.58' (60d spike S.E. side)

APPROVED LAND CORNER
 P.A. 345 OF 1990
 Osceola County

R. L. W.
4-20-2000

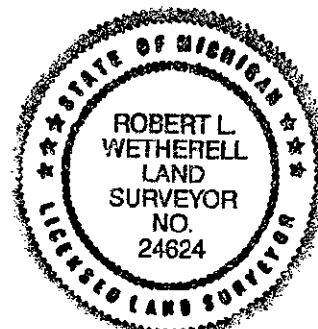

Signed by Robert L. Wetherell
 Surveyor's Michigan License No. 24624

Date April 25, 2000