

FEB 4 2000

LAND CORNER RECORDATION CERTIFICATE

FILING REQUIREMENT OF ACT 74, Mich. P.A. 1970

SECTION

For corners in Osceola	Located in:	Corner Code#
1. Public Land Survey	T 19 N R 10 W	C-1
	T R	
	T R	
	T R	
2. Property Controlling s in Section	T R	
	S T R	
3. Miscellaneous Property in Sec.	S T R	
	S T R	
4. Lot No. _____ Recorded Plat		
5. Private Claims		

Register of Deeds Stamp & File Number

	A	B	C	D	E	F	G	H	I	J	K	L	M
1													
2	6	5	4	3	2	1							
3													
4	7	8	9	10	11	12							
5													
6	18	17	16	15	14	13							
7													
8	19	20	21	22	23	24							
9													
10	30	29	28	27	26	25							
11													
12	31	32	33	34	35	36							
13													

I, Robert L. Wetherell, in a field survey on October 1 1999, do hereby certify that under requirements of P.A. 74, Michigan P.A. of 1970, the corner points mentioned in lines 1 and 2 above were in conformance with regulations and rules therefore as required in the current manual of survey instructions of the United States Department of the Interior, Bureau of Land Management or by decree of a Court of Law and/or that the corner points mentioned in lines 3, 4, and 5 above were in conformance with the rules of the Michigan Board of Land Surveyors or by a Decree Of a Court of Law; established, re-established, monumented, re-monumented, recovered, found as expressed below:

NOTE: ONLY ONE CORNER MAY BE RECORDED ON THIS CERTIFICATE.

Sec. Corner common to Sec's 5 & 6 on Twp Line
This corner is common to Corner 31 and 32, T20N,R10W

A. Description of original monument and accessories and/or subsequent restoration:

<u>1838 S.Sibley</u>	<u>1891-1904-A. Temple/F. Trumbull</u>	<u>1920-1927 Burdell Twp. Book</u>
#1- 9" Beech N54E 12 Lk.	Remonumentation of T19N-R10W	Pages 70 & 71 - Tile and Rod
#2- 8" Beech N40W 26Lk.	Set 3" Clay Tile	#3- PS S59W 19.4'
		#4- PS West 59.'
		#5- PS S36E 15.'
		Dist. North 2633.7'

(SEE OVER FOR CONTINUATION OF "A")

B. Description of corner evidence found and/or method applied in restoring of reestablishing corner:

I found Tile, D.N.R. Monument and Post in fence line North and East and in line with the fence to the West.

Condition of the accessories are as follow: #1 Gone. #2 Gone, #3 Gone, #4 Found, #5 Gone #6 Found in good condition, #7 Found in good condition, #8 Found in good condition, #9 Found in good condition and #10 Found in good condition.


C. Description of monument for corner and accessories established to perpetuate locating the position of the corner:

I accept the D.N.R. Monument as a substantial marker of the corner and is accepted as a careful and faithful reestablishment of the position of the original corner

- W. Gate Post S10W 71.45'(Nail on W. side)
- 5" Twin Maples N30E 16.62' (Nail on E. side) - #6
- 4" Maple S50E 27.22' (Nail on SW side) - #7
- 20" Tamarack S32W 58.65'(Nail on NW side) - #10

Signed by Robert L. Wetherell Date NOV. 9, 1999

Surveyor's Michigan License No. 24624

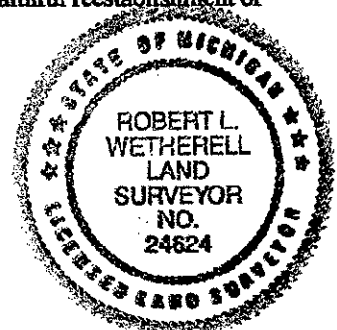

FORM APPROVED BY MICHIGAN STATE BOARD OF LAND SURVEYORS, JAN. 25, 1971
REVISED MAY 14, 1975
REVISED JAN., 1983
ADAPTED FOR WORD PROCESSING JANUARY, 1989

APPROVED LAND CORNER
P.A. 74 OF 1990
Osceola County

10-21-99
R.L.W.

CONTINUATION OF DESCRIPTION OF THE ORIGINAL MONUMENT AND ACCESSORIES AND/OR SUBSEQUENT AND RESTORATION.

1980 C. Roser LS 12028

LCRC

L. 2, Pg. 187

Fd. 3" Tile

Set DNR Monument & Post

#6- 5" Twin Maples N30E 16.3'

#7- 4" Maple S50E 26.9'

#8- 7" Maple S85W 41.6'

#9- Cr. Rd. N'y Due West 16.'

1998-M. McClung LS13037

Survey Record

Fd. DNR Monument & Tile

#6- Twin 5" Maples N30E 16.3'

#7- 4" Maple S50E 26.9'

#9- 16' East of C/L Road North

#10- 20" Tamarack S32W 58.8'

Dist North 2621.96'

RECORDED &
INDEXED

FEB 24 2006

SECTION

Janey Campbell

99 NOV 19 PM 12:10

OSCEOLA COUNTY
REGISTER OF DEEDS