

FEB 24 2000

LAND CORNER RECORDATION CERTIFICATE

FILING REQUIREMENT OF ACT 74, Mich. P.A. 1970

SECTION

For corners in Osceola

Located in: Corner Code#

- 1. Public Land Survey T 19 N R 10 W C-11
2. Property Controlling in Section S T R
3. Miscellaneous Property in Sec. S T R
4. Lot No. Recorded Plat
5. Private Claims

OSCEOLA COUNTY REGISTER OF DEEDS 99 DEC 23 PM 4:22

Register of Deeds Stamp & File Number

I, Robert L. Wetherell, in a field survey on November 22, 1999, do hereby certify that under requirements of P.A. 74, Michigan P.A. of 1970, the corner points mentioned in lines 1 and 2 above were in conformance with regulations and rules therefore as required in the current manual of survey instructions of the United States Department of the Interior, Bureau of Land Management or by decree of a Court of Law and/or that the corner points mentioned in lines 3, 4, and 5 above were in conformance with the rules of the Michigan Board of Land Surveyors or by a Decree Of a Court of Law; established, re-established, monumented, re-monumented, recovered, found as expressed below:

Table with 13 rows and 13 columns (A-M) containing numbers 1-36 in a grid pattern.

C-11 - 1/4 corner common to Sections 39, 30, 31 & 32, T19N, R10W, Osceola Co., Mi.

A. Description of original monument and accessories and/or subsequent restoration:

1838 - S. Sibley, G.L.O. #1 - 12" Beech S74°W 14 Links #2 - 10" Beech N42°E 14 Links

1922 - Twp. Book "Tile" #3 - Fence Post South 30.7' #4 - Fence Post North 32' #5 - Distance West 5141'

1999 - R.L. Wetherell, LS 24624 Survey recorded Liber 666, Pg. 752 Tile with railroad spike. #10 - G. Pole South 41.26' #11 - 13" R. Pine S44°W 144.12' #12 - 3" R. Pine N9°W 68.71' #13 - 4" Galv. Post S47°E 50.56'

1891-1904 - Temple/Trumbull/June The Township of Leroy (T19N, R10W) Was remonumented with 3" Clay Tiles

1971 - P. Salisbury, LS 13594 Mid Michigan Eng. & Sur. Liber 295, Pg. 559 #6 - 8" Pine South 84.97' #7 - 22" Poplar N70°W 92.45' #8 - 16" Poplar N15°E 86.00' #9 - Distance North 2619.70'

B. Description of corner evidence found and/or method applied in restoring of reestablishing corner:

I found a railroad spike in a 3" clay tile. Corner is in the centerline of East-West road and in line with old fence (down) to North.

Condition of the accessories are as follows: #1 Gone, #2 Gone, #3 Gone, #4 Gone, #5 Measured 5136.46', #6 Found in good condition, #7 gone, #8 Gone, #9 Measured 2619.80' #10 Found in good condition, #11 Found in good condition, #12 Found in good condition, #13 Found in good condition.

C. Description of monument for corner and accessories established to perpetuate locating the position of the corner:


I replaced the railroad spike with a 1-1/2" pipe with an Osceola County Remon Cap, and is accepted as a careful and faithful reestablishment of the position of the original corner.

- G. Pole South 41.26' (P.K. Nail in W. side) #10
13" R. Pine S44°W 144.12' (60d spike in N.W. side) #11
3" R. Pine N9°W 68.71' (center of tree) #12
4" Galvanized Post S47°E 50.56' (center of post) #13

Signed by Robert L. Wetherell

Date 12/16/99

Surveyor's Michigan License No. 24624

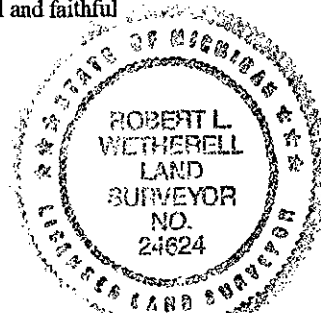

APPROVED LAND CORNER P.A. 345 OF 1990 Osceola County

12/9/99 R.L.W.

FORM APPROVED BY MICHIGAN STATE BOARD OF LAND SURVEYORS; JAN 28, 1971 REVISED MAY 14, 1976 REVISED JAN. 1983 ADAPTED FOR WORD PROCESSING JANUARY, 1999