

**SURVEY &
REMONUMENTATION**

JAN 17 1996

COMMISSION LAND CORNER RECORDATION CERTIFICATE

Filing Requirement of Act 74, Mich. P.A. 1970

For corners in

<u>Osceola</u> <small>(County)</small>	Located In:	Corner Code #:
	19N 10W	C-13
1. Public Land Survey	T _____ R _____	_____
	T _____ R _____	_____
	T _____ R _____	_____
	T _____ R _____	_____
2. Property Controlling in Section	S _____ T _____ R _____	_____
	S _____ T _____ R _____	_____
3. Miscellaneous Property in Sec.	S _____ T _____ R _____	_____

APPROVED LAND CORNER
P.A. 345 OF 1990
Osceola County

19 Oct. 1995
Matthew McClung

Register of Deeds Stamp & File Number

4. Lot No. _____, Recorded Plat _____
5. Private Claims _____

A	B	C	D	E	F	G	H	I	J	K	L	M
2	6	5	4	3	2	1						
3												
4	7	8	9	10	11	12						
5												
6	18	17	16	15	14	13						
7												
8	19	20	21	22	23	24						
9												
10	30	29	28	27	26	25						
11												
12	31	32	33	34	35	36						
13												

Matthew McClung October 14, 1995
I, _____, in a field survey on _____, 19_____, do hereby certify that under requirements of P.A. 74, Michigan P.A. of 1970, the corner points mentioned in lines 1 and 2 above were in conformance with regulations and rules therefore as required in the current manual of survey instructions of the United States Department of the Interior, Bureau of Land Management or by a decree of a Court of Law and/or that the corner points mentioned in lines 3, 4 and 5 above were in conformance with the rules of the Michigan Board of Land Surveyors or by a Decree of a Court of Law; established, re-established, monumented, re-monumented, recovered, found as expressed below:

NOTE: Not more than 4 corners, all in the same town and range, may be recorded on this certificate.


A. Description of original monument and accessories and/or subsequent restoration:

The original corner was set by deputy surveyor John Hodgson on December 13 1837. Set wood post 80.00 chains from the East.
Elm 14" S4.5W 211 lks.
Cherry 8" S5.75E 216 lks.

From 1891 to 1904 approximately, Osceola County had a remonumentation program, in which surveyors Temple and Trumbull, did the work. For the most part, a 3" glazed tile filled with cinders from a forge, were placed at each government set corner in the township. There were supposed to be 3 tile per corner, placed atop of each other, (continued on back)

B. Description of corner evidence found and/or method applied in restoring or reestablishing corner:

Found fence post, fence post is now down, North of corner. Found old fence wire in area of corner. Place Osceola County Monument 6" above surface, 16.5 feet East of Lincoln Corner and on line extended over Lincoln Corner from One Quarter Corner to West.

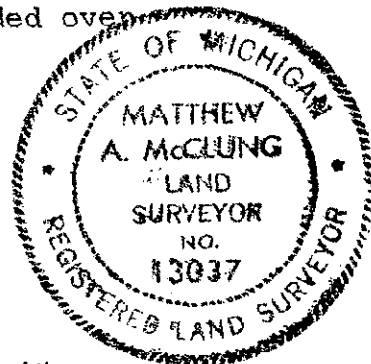

C. Description of monument for corner and accessories established to perpetuate locating the position of the corner:

Corner C-13. Osceola County Monument, which is a 3" brass cap mounted on a 1" pipe 30" in length.
12" Spruce S18E 211.38 feet.
12" Blue Spruce S1W 220.31 feet.
6" Maple S5W 142.41 feet.
10" White Pine S38W 229.38 feet.

Signed by Matthew McClung Date October 14, 1995
Surveyor's Michigan License No. 13037

thereby making the corner 4 feet long. Sometimes a solid tile, with a cross in the top was used, and sometimes a 1/2" iron bars were added to the tile. Notes of the work were kept in ledgers, and given to the townships, and 5 of the townships have been recorded in the County records.

OSCEOLA COUNTY
REGISTER OF DEEDS

95 NOV 13 PM 4:53

Nancy Crawford