

**SURVEY &  
REMONUMENTATION**

**LAND CORNER RECORDATION CERTIFICATE**  
Filing Requirement of Act 74, Mich. P.A. 1970

DEC 16 1996

For corners in

Osceola

(County)

Located In:

Corner Code #

1. Public Land Survey

T 19N R R10W Corner Code # F-5

T \_\_\_\_\_ R \_\_\_\_\_

T \_\_\_\_\_ R \_\_\_\_\_

T \_\_\_\_\_ R \_\_\_\_\_

2. Property Controlling  
in Section

S \_\_\_\_\_ T \_\_\_\_\_ R \_\_\_\_\_

S \_\_\_\_\_ T \_\_\_\_\_ R \_\_\_\_\_

3. Miscellaneous  
Property in Sec.

S \_\_\_\_\_ T \_\_\_\_\_ R \_\_\_\_\_

S \_\_\_\_\_ T \_\_\_\_\_ R \_\_\_\_\_

**COMMISSION**

APPROVED LAND CORNER  
P.A. 345 OF 1990  
Osceola County

*Matthew McClung*  
10 Oct 1996

Register of Deeds Stamp & File Number

4. Lot No. \_\_\_\_\_, Recorded Plat \_\_\_\_\_

5. Private Claims \_\_\_\_\_

I, Matthew McClung in a field survey on 10-7, 1996 do hereby state that under requirements of P.A. 74, Michigan P.A. of 1970, the corner points mentioned in lines 1 and 2 above were in conformance with regulations and rules therefore as required in the current manual of survey instructions of the United States Department of the Interior, Bureau of Land Management or by a decree of a Court of Law and /or that the corner points mentioned in lines 3, 4 and 5 above were in conformance with the rules of the Michigan Board of Land Surveyors or by a Decree of a Court of Law; established, re-established, monumented, recovered, found as expressed below:

NOTE: Not more than 2 corners, all in the same town and range, may be recorded on this certificate.

	A	B	C	D	E	F	G	H	I	J	K	L	M
1													
2	6		5		4		3		2		1		
3													
4	7		8		9		10		11		12		
5													
6	18		17		16		15		14		13		
7													
8	19		20		21		22		23		24		
9													
10	30		29		28		27		26		25		
11													
12	31		32		33		34		35		36		
13													

A. Description of original monument and accessories and/or subsequent restoration:

The original corner was set by deputy surveyor Sylvester Sibley on 12 April 1838. Set wood post 39.84 chains from the East.

Elm 8" S12E 54 lks.

Cedar 7" N10W 18 lks.

From 1891 to 1904 approximately, Osceola County had a remonumentation program, in which surveyors Temple and Trumbull, did the work. For the most part, a 3" glazed tile filled with cinders from a forge, were placed at each government set corner in the township. There were supposed to be 3 tile per corner, placed atop of each other, (continued on back)

B. Description of corner evidence found and/or method applied in restoring or reestablishing corner:

Found 1/2" iron rebar and 6" X 3" wood stake (government), 3" above ground surface. Found 3" tile at surface. Placed Osceola County Monument in tile 3" above ground surface.

C. Description of monument for corner and accessories established to perpetuate locating the position of the corner:


Corner F-5. Osceola County Monument, which is a 3" brass cap monument on a 1" pipe 18" in length.

14" R. Pine N56E 3.20 feet.

6" Tamarack S72E 15.10 feet.

5" W. Pine S80W 8.58 feet.

8" Tamarack N55W 25.65 feet.

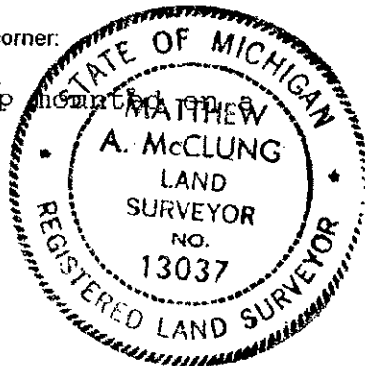

Signed by *Matthew McClung*  
Surveyor's Michigan License No. 13037

Date October 7, 1996

thereby making the corner 4 feet long. Sometimes a solid tile, with a cross in the top was used, and sometimes a 1/2" iron bars were added to the tile. Notes of the work were kept in ledgers, and given to the townships, and 5 of the townships have been entered in the County Surveyor records.

I have shown 2 PA 132: Liber 514, page 625; Liber 575, Page 611.

*Mary Crawford*

OSCEOLA COUNTY  
REGISTER OF DEEDS  
96 NOV -7 AM 11:55

SURVEY &  
REMONUMENTATION

DEC 1 6 1996

COMMISSION