

RF

FEB 24 2000

SECTION

LAND CORNER RECORDATION CERTIFICATE

FILING REQUIREMENT OF ACT 74, Mich. P.A. 1970

For corners in <u>Osceola</u>	Located in:	Corner Code#	
1. Public Land Survey	<u>T 19 N</u>	<u>R 10 W</u>	<u>F-13</u>
	<u>T</u>	<u>R</u>	
	<u>T</u>	<u>R</u>	
	<u>T</u>	<u>R</u>	
2. Property Controlling in Section	<u>S</u>	<u>T</u>	<u>R</u>
	<u>S</u>	<u>T</u>	<u>R</u>
3. Miscellaneous Property in Sec.	<u>S</u>	<u>T</u>	<u>R</u>
	<u>S</u>	<u>T</u>	<u>R</u>
4. Lot No. _____ Recorded Plat _____			
5. Private Claims _____			

OSCEOLA COUNTY  
 REGISTER OF DEEDS  
 99 NOV 19 PM 12:10  
*Hancy Campbell*

Register of Deeds Stamp & File Number

I, Robert L. Wetherell, in a field survey on September 30, 1999, do hereby certify that under requirements of P.A. 74, Michigan P.A. of 1970, the corner points mentioned in lines 1 and 2 above were in conformance with regulations and rules therefore as required in the current manual of survey instructions of the United States Department of the Interior, Bureau of Land Management or by decree of a Court of Law and/or that the corner points mentioned in lines 3, 4, and 5 above were in conformance with the rules of the Michigan Board of Land Surveyors or by a Decree Of a Court of Law; established, re-established, monumented, re-monumented, recovered, found as expressed below:

A	B	C	D	E	F	G	H	I	J	K	L	M
1												
2	6	5	4	3	2	1						
3												
4	7	8	9	10	11	12						
5												
6	18	17	16	15	14	13						
7												
8	19	20	21	22	23	24						
9												
10	30	29	28	27	26	25						
11												
12	31	32	33	34	35	36						
13												

F-13 - S. 1/4 Corner Section 33, T19N, R10W, Osceola Co., Mi.

**A. Description of original monument and accessories and/or subsequent restoration:**

1837 - J. Hodgson, G.L.O.

#1 - 10" Hemlock N35°W 19 Links  
 #2 - 8" Hemlock N45°E 19 Links

1891-1904 - Temple/Trumbull

The Township of Leroy - T19N, R10W was remonumented with 3" Clay Tiles.

**B. Description of corner evidence found and/or method applied in restoring of reestablishing corner:**

I found a 3/8" Rod in center of 3" Clay Tile. Corner is 2 feet North of old fence post and 12 feet more or less East of North and South right of way fence. This corner is incorrectly recorded in Liber 02, Page 46 of the corner records and in Liber 511, Page 146 of Surveys as the North 1/4 corner of Section 4, T18N, R10W.

Condition of the accessories are as follows: #1 Gone, #2 Gone


**C. Description of monument for corner and accessories established to perpetuate locating the position of the corner:**

I placed a 1" x 18" Pipe with Osceola County Remon Cap in the center of Tile and is accepted as a careful and faithful reestablishment of the position of the original corner.

- 8" Maple (in clump) S87°E 23.91' (60d spike in S. side)
- 7" Tri. Maple S31°E 31.65' (60d spike in E. side)
- 4" Maple N40°W 17.40' (60d spike in S. side)
- Concrete right of way marker - West 13.65'
- Osceola County Monument - West 18.35' (N. 1/4 Cor. Sec. 4, T18N, R10W)
- Centerline South bound lane U.S. 131 - East 144' more or less.

APPROVED LAND CORNER  
 P.A. 345 OF 1990  
 Osceola County

*10-21-99*  
Robert L. Wetherell

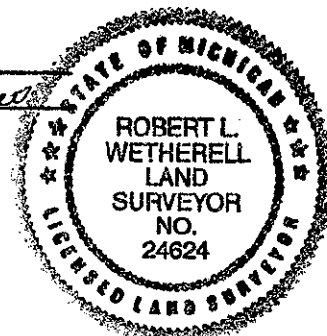

Signed by

*Robert L. Wetherell*

Date Nov. 9, 1999

Surveyor's Michigan License No. 24624