

SURVEY &
REMONUMENTATION

LAND CORNER RECORDATION CERTIFICATE
Filing Requirement of Act 74, Mich. P.A. 1970

DEC 16 1996

For corners in

<u>Osceola</u> (County)	Located In:	Corner Code #
1. Public Land Survey	<u>T19N R10W</u>	<u>G-5</u>
	T <u> </u> R <u> </u>	<u> </u>
	T <u> </u> R <u> </u>	<u> </u>
	T <u> </u> R <u> </u>	<u> </u>
2. Property Controlling in Section	S <u> </u> T <u> </u> R <u> </u>	<u> </u>
	S <u> </u> T <u> </u> R <u> </u>	<u> </u>
3. Miscellaneous Property in Sec.	S <u> </u> T <u> </u> R <u> </u>	<u> </u>
	S <u> </u> T <u> </u> R <u> </u>	<u> </u>

COMMISSION

APPROVED LAND CORNER
P.A. 345 OF 1990
Osceola County

Matthew McClung
10 Oct 1996

Register of Deeds Stamp & File Number

4. Lot No. _____, Recorded Plat _____
5. Private Claims _____

I, Matthew McClung, in a field survey on 10-7, 1996 do hereby state that under requirements of P.A. 74, Michigan P.A. of 1970, the corner points mentioned in lines 1 and 2 above were in conformance with regulations and rules therefore as required in the current manual of survey instructions of the United States Department of the Interior, Bureau of Land Management or by a decree of a Court of Law and/or that the corner points mentioned in lines 3, 4 and 5 above were in conformance with the rules of the Michigan Board of Land Surveyors or by a Decree of a Court of Law; established, re-established, monumented, recovered, found as expressed below:

NOTE: Not more than 2 corners, all in the same town and range, may be recorded on this certificate.

	A	B	C	D	E	F	G	H	I	J	K	L	M
1													
2		6		5		4		3		2		1	
3													
4		7		8		9		10		11		12	
5													
6		13		17		16		15		14		13	
7													
8		19		20		21		22		23		24	
9													
10		30		29		28		27		26		25	
11													
12		31		32		33		34		35		36	
13													

A. Description of original monument and accessories and/or subsequent restoration:

The original corner was set by deputy surveyor Sylvester Sibley on 12 April 1838. Set wood post 80.00 chains from the South.

Beech 14" N57E 51 lks.

Beech 10" N26 1/2E 51 lks.

From 1891 to 1904 approximately, Osceola County had a remonumentation program, in which surveyors Temple and Trumbull, did the work. For the most part, a 3" glazed tile filled with cinders from a forge, were placed at each government set corner in the township. There were supposed to be 3 tile per corner, placed atop of each other, (continued on back)

B. Description of corner evidence found and/or method applied in restoring or reestablishing corner:

Found 1/2" iron rebar in centerlines of the East and West road and in the North and South road 8" below surface. Excavated to 14" and found 3/8" strap iron. excavated to 23" and found steel leg off of old school desk. Excavated to 25" and found 1/2" iron rod. Excavated to 47" and found no other evidence of corner. Placed Osceola County Monument in position of 1/2" iron rod 6" below road surface.

C. Description of monument for corner and accessories established to perpetuate locating the position of the corner:

Corner G-5. Osceola County Monument, which is a 3" brass cap mounted on a 1" pipe 18" in length.

Power Pole S55W 83.62 feet.


Telephone Box N50W 47.75 feet.

3" Decorative Pine N66W 81.58 feet.

24" Double Maple N75W 143.55 feet.

Signed by *Matthew McClung*
Surveyor's Michigan License No. 13037

Date October 7, 1996

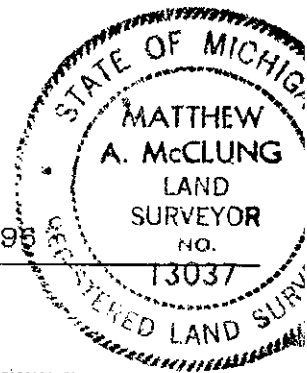

OSCEOLA COUNTY
REGISTER OF DEEDS

96 NOV -7 AM 11: 56

Nancy Crawford

thereby making the corner 4 feet long. Sometimes a solid tile, with a cross in the top was used, and sometimes a 1/2" iron bars were added to the tile. Notes of the work were kept in ledgers, and given to the townships, and 5 of the townships have been entered in the County Surveyor records.

Recorded in the LeRoy Township Book, Front pages, Page 4

I have shown 2 L.C.R.C: Liber 1, Page 84; Liber 2, Page 164.

I have shown 2 PA 132: Liber 374, page 486; Liber 289, Page 111.

SURVEY &
REMONUMENTATION

DEC 1 6 1996

COMMISSION