


SURVEY & REMONUMENTATION

DEC 13 2000

SECTION LAND CORNER RECORDATION CERTIFICATE
 FILING REQUIREMENT OF ACT 74, Mich. P.A. 1970

For corners in Osceola Located in: Corner Code#

1. Public Land Survey	T	19 N	R	10 W	I-13
	T		R		
	T		R		
	T		R		
2. Property Controlling in Section	S	T	R		
	S	T	R		
3. Miscellaneous Property in Sec.	S	T	R		
	S	T	R		
4. Lot No. _____ Recorded Plat _____					
5. Private Claims _____					

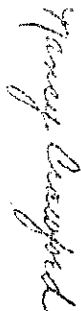
OSCEOLA COUNTY REGISTER OF DEEDS
00 MAY -5 PM 2:52
 Register of Deeds Stamp & File Number

	A	B	C	D	E	F	G	H	I	J	K	L	M
1													
2	6	5	4	3	2	1							
3													
4	7	8	9	10	11	12							
5													
6	18	17	16	15	14	13							
7													
8	19	20	21	22	23	24							
9													
10	30	29	28	27	26	25							
11													
12	31	32	33	34	35	36							
13													

I, Robert L. Wetherell, in a field survey on March 21, 2000, do hereby certify that under requirements of P.A. 74, Michigan P.A. of 1970, the corner points mentioned in lines 1 and 2 above were in conformance with regulations and rules therefore as required in the current manual of survey instructions of the United States Department of the Interior, Bureau of Land Management or by decree of a Court of Law and/or that the corner points mentioned in lines 3, 4, and 5 above were in conformance with the rules of the Michigan Board of Land Surveyors or by a Decree Of a Court of Law; established, re-established, monumented, re-monumented, recovered, found as expressed below:

I-13- Section corner common to Sections 34 & 35, T19N, R10W, on Twp., line.

A. Description of original monument and accessories and/or subsequent restoration:

1837 - J. Hodgson, G.L.O.
 #1 - 14" Beech N43°E 43 Links
 #2 - 8" Beech N71°W 5 Links

1891-1904 - Temple/Trumbull
 Remonumentation of T19N, R10W.
 Set 3" Clay Tiles.

R.L. Wetherell, LS 24624
 Found 3" Clay Tile 15.16' East of corner common to Sec. 2 & 3, T18N, R10W,
 No accessories given.

B. Description of corner evidence found and/or method applied in restoring of reestablishing corner:

I found a 3" Clay Tile with cinders in line with fences North and West.


Condition of the accessories are as follows: #1 Gone, #2 Gone.

C. Description of monument for corner and accessories established to perpetuate locating the position of the corner:

I placed a 1" x 18" Iron Pipe with Osceola County Remon Cap in the center of the 3" Clay Tile, and is accepted as a careful and faithful reestablishment of the position of the original corner.

- 20" Maple Clump N65°E 64.44' (60d spike S. side)
- 13" R. Pine N12°E 88.52' (60d spike E. side)
- 36" Cherry S84°W 24.12' (60d spike S. side)
- Sec. Cor. Sec. 2 & 3, T18N, R10W - Due West 15.16' (Osceola Remon Iron)
- 4" R. Pine S38°E 57.49' (60d spike S.W. side)

APPROVED LAND CORNER
 P.A. 345 OF 1990
 Osceola County
R. L. W.
 4-20-2000

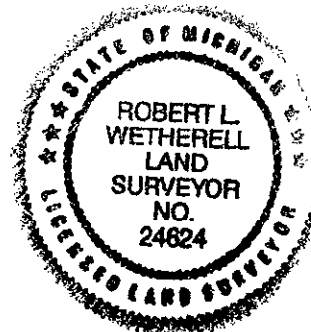

Signed by Robert L. Wetherell Date April 25, 2000
 Surveyor's Michigan License No. 24624

FORM APPROVED BY MICHIGAN STATE BOARD OF LAND SURVEYORS, JAN 28, 1971
 REVISED MAY 14, 1975
 REVISED JAN., 1983
 ADAPTED FOR WORD PROCESSING JANUARY, 1999