

# SURVEY & REMONUMENTATION

APR 25 1995

## LAND CORNER RECORDATION CERTIFICATE Filing Requirement of Act 74, Mich. P.A. 1970

### COMMISSION

For corners in

Osceola <small>(County)</small>	Located In:	Corner Code #
1. Public Land Survey	T <u>19</u> N R <u>10</u> W	<u>M-8</u>
	T _____ R _____	_____
	T _____ R _____	_____
	T _____ R _____	_____
2. Property Controlling in Section	S _____ T _____ R _____	_____
	S _____ T _____ R _____	_____
3. Miscellaneous Property in Sec.	S _____ T _____ R _____	_____
	S _____ T _____ R _____	_____
4. Lot No. _____, Recorded Plat _____		
5. Private Claims _____		

APPROVED LAND CORNER  
P.A. 345 OF 1990  
Osceola County

*Matthew McClung*  
29 Nov. 1994

Register of Deeds Stamp & File Number

I, Matthew McClung, in a field survey on November 28, 1994 do hereby certify that under requirements of P.A. 74, Michigan P.A. of 1970, the corner points mentioned in lines 1 and 2 above were in conformance with regulations and rules therefore as required in the current manual of survey instructions of the United States Department of the Interior, Bureau of Land Management or by a decree of a Court of Law and/or that the corner points mentioned in lines 3, 4 and 5 above were in conformance with the rules of the Michigan Board of Land Surveyors or by a Decree of a Court of Law; established, re-established, monumented, re-monumented, recovered, found as expressed below:

**NOTE: Not more than 4 corners, all in the same town and range, may be recorded on this certificate.**

	A	B	C	D	E	F	G	H	I	J	K	L	M
2	6	5	4	3	2	1							
3													
4	7	8	9	10	11	12							
5													
6	18	17	16	15	14	13							
7													
8	19	20	21	22	23	24							
9													
10	30	29	28	27	26	25							
11													
12	31	32	33	34	35	36							
13													


**A. Description of original monument and accessories and/or subsequent restoration:**

The original corner was set by deputy surveyor Sylvester Sibley on July 7, 1838. Set wood post 40.00 chains from the South.  
Black Ash 6" S76W 14 lks.  
Elm 16" N16W 20 lks.

From 1891 to 1904 approximately, Osceola County had a remonumentation program, in which surveyors Temple and Trumbull, did the work. For the most part, a 3" glazed tile filled with cinders from a forge, were placed at each government set corner in the township. There were supposed to be 3 tile per corner, placed atop of each other, (continued on back)

**B. Description of corner evidence found and/or method applied in restoring or reestablishing corner:**

Found 1/2" rod with cap by James Ray in centerline of asphalt road. Set Osceola County Monument over 1/2" rod 1" below road surface. Corner is in east and west fences. Corner is in road fill 8 feet over original corner.

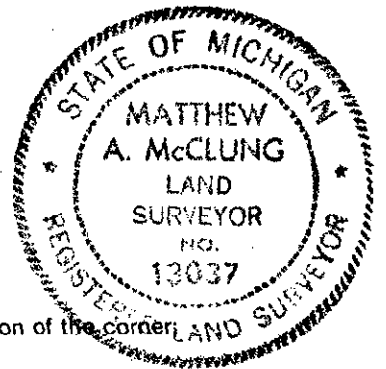

**C. Description of monument for corner and accessories established to perpetuate locating the position of the corner:**

Corner M-8. Osceola County Monument, which is a 3" brass cap mounted on a 1" pipe 18" in length.  
Power pole S10W 184.80 feet.  
8" W. Ash S70E 54.70 feet.  
16" Sugar Maple S15E 134.60 feet.  
13" W. Ash S45E 89.45 feet.

Signed by Matthew McClung  
Surveyor's Michigan License No. 13037

Date: November 28, 1993

OSCEOLA COUNTY  
REGISTER OF DEEDS

94 DEC -7 PM 2:51

*Nancy Crawford*

thereby making the corner 4 feet long. Sometimes a solid tile, with a cross in the top was used, and sometimes a 1/2" iron bars were added to the tile. Notes of the work were kept in ledgers, and given to the townships, and 5 of the townships have been recorded in the County records.

OSCEOLA COUNTY  
REGISTER OF DEEDS  
RECORDED COPY