

SURVEY & REMONUMENTATION

NOV 01 1999

SECTION

LAND CORNER RECORDATION CERTIFICATE
Filing Requirement of Act 74, Mich. P.A. 1970

For corners in Osceola (County)

Located In: 19N 7W Corner Code # C-2

1. Public Land Survey	T	R	_____	
	T	R	_____	
	T	R	_____	
	T	R	_____	
2. Property Controlling in Section	S	T	R	_____
	S	T	R	_____
3. Miscellaneous Property in Sec.	S	T	R	_____
	S	T	R	_____

4. Lot No. _____, Recorded Plat _____

5. Private Claims _____

Register of Deeds Stamp & File Number

	A	B	C	D	E	F	G	H	I	J	K	L	M
1													
2	6		5		4		3		2		1		
3													
4	7		8		9		10		11		12		
5													
6	18		17		16		15		14		13		
7													
8	19		20		21		22		23		24		
9													
10	30		29		28		27		26		25		
11													
12	31		32		33		34		35		36		
13													

I, Robert L. Wetherell, in a field survey on Aug 12, 1999 do hereby state that under requirements of P.A. 74, Michigan P.A. of 1970, the corner points mentioned in lines 1 and 2 above were in conformance with regulations and rules therefore as required in the current manual of survey instructions of the United States Department of the Interior, Bureau of Land Management or by a decree of a Court of Law and /or that the corner points mentioned in lines 3, 4 and 5 above were in conformance with the rules of the Michigan Board of Land Surveyors or by a Decree of a Court of Law; established, re-established, monumented, recovered, found as expressed below:

NOTE: Not more than 2 corners, all in the same town and range, may be recorded on this certificate.

C-2 E 1/4 Corner of Section 6, T19N, R7W


- A. Description of original monument and accessories and/or subsequent restoration:
- 1856 - E. Coleman
#1-6" Lynn N30E 6 Lks.
#2-19" Hemlock S13W 31 Lks
 - 1891 - 1904 - A. Temple/F. Trumbull
Remonumentation of T19N, R7W
Set 3" Clay tiles
 - Undated Middle Branch Twp Book
Front Pages, page 5
1/4 5 & 6
#3 - Apple W. 37.7'
#4 - F. Post E. 37.7'

(SEE OVER FOR CONTINUATION OF "A")

B. Description of corner evidence found and/or method applied in restoring or reestablishing corner:
Found Osceola County Monument in line with fences East & West and 3' West of C/L of North and South Road.
Condition of the accessories are as follows: #1 Gone, #2Gone, #3Gone, #4Gone, #5 Found in good condition, #6 Found in good condition, #7 Found in good condition and #8 Found in good condition.

C. Description of monument for corner and accessories established to perpetuate locating the position of the corner:
I accepted Osceola County Monument (1 1/2" Pipe with Osceola County Remon. Cap) as a substantial marker for the corner and is accepted as a careful and faithful reestablishment of the position of the original corner.

- P. Pole East 70.43' #7
- 8" W. Ash N75W 28.20'
- 5" DbI. W. Ash N40E 55.55'
- F. Post N70W 30.08' #5

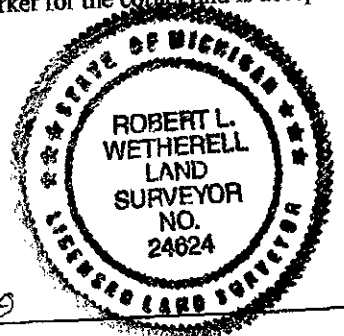

Signed by Robert L. Wetherell 24624

Date 8-26-99

Surveyor's Michigan License No. _____
APPROVED LAND CORNER
P.A. 345 OF 1990
Osceola County

8-26-99
R. L. W.

CONTINUATION OF DESCRIPTION OF ORIGINAL MONUMENT AND ACCESSORIES AND/OR SUBSEQUENT RETORATION.

1940 - F. McClung

- 8 - Iron
- #4 - Fence Post E 37.7'
- #3 - Apple W. 37.7'

1998 - McClung LS 13037

- Survey record
- L. 652, Pg. 819
- Fd. Strap iron, 1/2 rod, wood stake, 2 pipes & tile
- Set Osceola County Monument in center of Tile
- #5 - F. Post N70W 30.08'
- #6 - F. Post N30W 46.20'
- #7 - P. Pole East 70.43'
- #8 - 4" Elm S22W 65.97'

OSCEOLA COUNTY
REGISTER OF DEEDS
99 SEP - 3 AM 11:48
Nancy Campbell

SURVEY &
REMONUMENTATION

NOV 01 1999

SECTION