

**SURVEY &  
REMONUMENTATION**

DEC 13 2000

**SECTION LAND CORNER RECORDATION CERTIFICATE**  
FILING REQUIREMENT OF ACT 74, Mich. P.A. 1970

For corners in Osceola Located in: Corner Code#

1. Public Land Survey T 19 N R 7 W C-9  
 T \_\_\_\_\_ R \_\_\_\_\_  
 T \_\_\_\_\_ R \_\_\_\_\_  
 T \_\_\_\_\_ R \_\_\_\_\_

2. Property Controlling S T R  
 in Section S T R  
 S T R

3. Miscellaneous S T R  
 Property in Sec. S T R

4. Lot No. \_\_\_\_\_ Recorded Plat \_\_\_\_\_

5. Private Claims \_\_\_\_\_

OSCEOLA COUNTY REGISTER OF DEEDS  
00 MAY -5 PM 2:51  
*George Brantford*

Register of Deeds Stamp & File Number

	A	B	C	D	E	F	G	H	I	J	K	L	M
1													
2	6	5	4	3	2	1							
3													
4	7	8	9	10	11	12							
5													
6	18	17	16	15	14	13							
7													
8	19	20	21	22	23	24							
9													
10	30	29	28	27	26	25							
11													
12	31	32	33	34	35	36							
13													

I, Robert L. Wetherell, in a field survey on March 29, 2000, do hereby certify that under requirements of P.A. 74, Michigan P.A. of 1970, the corner points mentioned in lines 1 and 2 above were in conformance with regulations and rules therefore as required in the current manual of survey instructions of the United States Department of the Interior, Bureau of Land Management or by decree of a Court of Law and/or that the corner points mentioned in lines 3, 4, and 5 above were in conformance with the rules of the Michigan Board of Land Surveyors or by a Decree of a Court of Law; established, re-established, monumented, re-monumented, recovered, found as expressed below:

**C-9 - Section corner common to Sections 19, 20, 29 & 30, T19N, R7W**

**A. Description of original monument and accessories and/or subsequent restoration:**

**1856 - F. Coleman, G.L.O.**  
 #1 - 14" Hemlock N29°E 40 Links  
 #2 - 4" Sugar S38°W 23 Links

**Undated from Co. Sur. Twp. Notes**  
 "Pipe"  
 #5 - Elm S.W. 63'  
 #6 - Elm N.W. 52.6'

**1996 - R.L. Wetherell, LS 24624**  
 Found an old 1" Pipe badly bent.  
 Found stones and broken tile under pipe.  
 #7 - 18" W. Pine East 94.76'  
 #8 - 12" Tw. Maple S40°E 82.02'  
 #9 - 11" R. Pine S65°W 78.65'  
 #10 - 4" W. Pine N18°W 99.50'

**1891-1904 - F. Trumbull, Co. Sur.**  
 Remonumentation of T19N, R7W.  
 "Identified by N.B.T.'s & Stone".  
 #3 - 28" Pine S51°W 25 Links  
 #4 - 28" Pine N48°W 135 Links

**B. Description of corner evidence found and/or method applied in restoring of reestablishing corner:**

I found a 1" pipe with stones and lots of broken tile around it. It fits well with Trumbull's accessory #4. Corner is in the center of road North and South and seasonal road East and West.

Condition of the accessories are as follows: #1 Gone, #2 Gone, #3 Gone, #4 Found Stump in good condition, #5 Gone, #6 Gone, #7 Found in good condition, #8 Found in good condition, #9 Found in good condition, #10 Found in good condition.


**C. Description of monument for corner and accessories established to perpetuate locating the position of the corner:**

I replaced the 1" Pipe with a 1" x 18" Pipe with Osceola County Remon Cap, and is accepted as a careful and faithful reestablishment of the position of the original corner.

P. Stump N45°W 89' (to face) #4  
 18" W. Pine East 94.76' (60d spike in N. side) #7  
 Tw. Maple S40°E 82.02' (60d spike in S.W. side) #8  
 11" R. Pine S65°W 78.65' (60d spike in N. side) #9  
 4" W. Pine N18°W 99.50' (60d spike in E. side) #10

APPROVED LAND CORNER  
 P.A. 345 OF 1990  
 Osceola County

*R. L. Wetherell*  
 4-20-2000

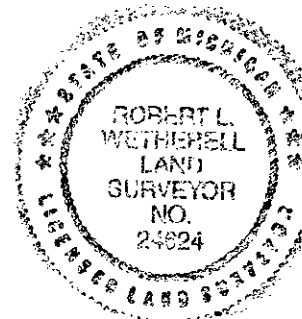

Signed by Robert L. Wetherell  
 Surveyor's Michigan License No. 24624

Date April 25, 2000