

SURVEY & REMONUMENTATION

DEC 13 2000

SECTION

LAND CORNER RECORDATION CERTIFICATE

FILING REQUIREMENT OF ACT 74, Mich. P.A. 1970

For corners in Osceola

Located in: Corner Code#

- 1. Public Land Survey

<u>T 19 N</u>	<u>R 7 W</u>	<u>C-10</u>
<u>T</u>	<u>R</u>	
<u>T</u>	<u>R</u>	
<u>T</u>	<u>R</u>	
- 2. Property Controlling in Section

<u>S</u>	<u>T</u>	<u>R</u>
<u>S</u>	<u>T</u>	<u>R</u>
- 3. Miscellaneous Property in Sec.

<u>S</u>	<u>T</u>	<u>R</u>
<u>S</u>	<u>T</u>	<u>R</u>
- 4. Lot No. Recorded Plat
- 5. Private Claims

OSCEOLA COUNTY
REGISTER OF DEEDS
00 MAY -5 PM 2:51
Yvonne Crawford

Register of Deeds Stamp & File Number

I, Robert L. Wetherell, in a field survey on March 29, 2000, do hereby certify that under requirements of P.A. 74, Michigan P.A. of 1970, the corner points mentioned in lines 1 and 2 above were in conformance with regulations and rules therefore as required in the current manual of survey instructions of the United States Department of the Interior, Bureau of Land Management or by decree of a Court of Law and/or that the corner points mentioned in lines 3, 4, and 5 above were in conformance with the rules of the Michigan Board of Land Surveyors or by a Decree Of a Court of Law; established, re-established, monumented, re-monumented, recovered, found as expressed below:

	A	B	C	D	E	F	G	H	I	J	K	L	M
1													
2	6	5	4	3	2	1							
3													
4	7	8	9	10	11	12							
5													
6	18	17	16	15	14	13							
7													
8	19	20	21	22	23	24							
9													
10	30	29	28	27	26	25							
11													
12	31	32	33	34	35	36							
13													

E-9 - Section corner common to Sections 29 & 30, T19N, R7W

A. Description of original monument and accessories and/or subsequent restoration:

- | | | |
|--|---|---|
| <p>1856 - F. Coleman, G.L.O.
 #1 - 12" Hemlock N39°W 38 Links
 #2 - 12" Y. Birch S53°E 36 Links</p> | <p>1891-1904 - F. Trumbull, Co. Sur.
 Remonumentation of T19N, R7W
 "Identified by O.B.T. & Meas."
 #3 - 22" Pine S16°E 91 Links
 #4 - 18" Pine S68 ½°E 59 Links</p> | <p>1996 - R.L. Wetherell, LS 24624
 Found ½" Pipe.
 #5 - 14" W. Pine S80°W 52.90'
 #6 - 6" Pipe Post N8°W 94.52'
 #7 - 7" W. Pine N72°E 50.30'
 #8 - 8" Maple S77°E 60.05'</p> |
|--|---|---|

B. Description of corner evidence found and/or method applied in restoring of reestablishing corner:

I found a ½" pipe in line with old school yard fence to the west. Corner is 4 feet more or less West of centerline of North and South road. I made a substantial dig but was unable to recover the clay tile. The found pipe fits very well with Trumbull's accessory No. 4. I measured the following distances: 2628.99 feet North to the Section corner. 2626.75 feet South to the Section corner.


Condition of the accessories are as follows: #1 Gone, #2 Gone, #3 Gone, #4 Found Stump (S64°E 38.6').

C. Description of monument for corner and accessories established to perpetuate locating the position of the corner:

I replaced the ½" pipe with a 1" x 18" pipe with Osceola County Remon Cap, and is accepted as a careful and faithful reestablishment of the position of the original corner.

- P. Stump S64°E 38.6' (to face) #4
- 14" W. Pine S80°W 52.90' (60d spike S. side) #5
- 6" Pipe Post N8°W 94.52' (center) #6
- 7" W. Pine N72°E 50.30' (60d spike in N. side) #7
- 8" Maple S77°E 60.05' (60d spike S. side) #8

APPROVED LAND CORNER
 P.A. 345 OF 1990
 Osceola County
R. L. W.
4-20-2000

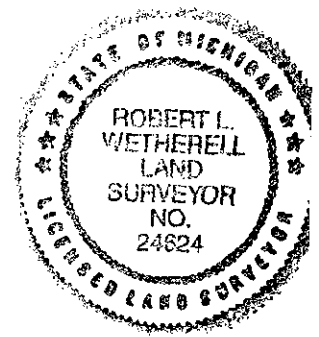

Signed by Robert L. Wetherell
 Surveyor's Michigan License No. 24624

Date April 25, 2000

FORM APPROVED BY MICHIGAN STATE BOARD OF LAND SURVEYORS, JAN. 28, 1971
 REVISED MAY 14, 19
 REVISED JAN., 19
 ADAPTED FOR WORD PROCESSING JANUARY, 19