

SURVEY & REMONUMENTATION

DEC 13 2000

SECTION

LAND CORNER RECORDATION CERTIFICATE

FILING REQUIREMENT OF ACT 74, Mich. P.A. 1970

For corners in Osceola Located in: Corner Code#


1. Public Land Survey T 19 N R 7 W C-11
 T _____ R _____
 T _____ R _____
 T _____ R _____

2. Property Controlling S _____ T _____ R _____
 in Section S _____ T _____ R _____

3. Miscellaneous S _____ T _____ R _____
 Property in Sec. S _____ T _____ R _____

4. Lot No. _____ Recorded Plat _____

5. Private Claims _____

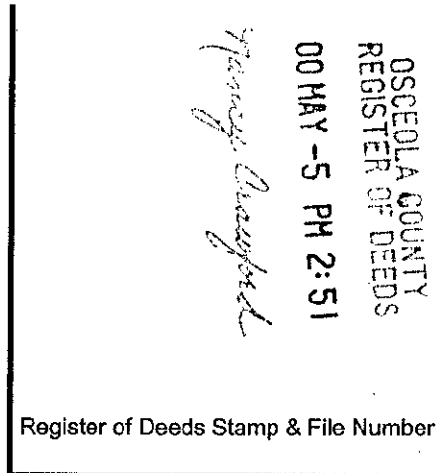

	A	B	C	D	E	F	G	H	I	J	K	L	M
1													
2	6	5	4	3	2	1							
3	7	8	9	10	11	12							
4													
5													
6	18	17	16	15	14	13							
7													
8	19	20	21	22	23	24							
9													
10	30	29	28	27	26	25							
11													
12	31	32	33	34	35	36							
13													

I, Robert L. Wetherell, in a field survey on March 29, 2000, do hereby certify that under requirements of P.A. 74, Michigan P.A. of 1970, the corner points mentioned in lines 1 and 2 above were in conformance with regulations and rules therefore as required in the current manual of survey instructions of the United States Department of the Interior, Bureau of Land Management or by decree of a Court of Law and/or that the corner points mentioned in lines 3, 4, and 5 above were in conformance with the rules of the Michigan Board of Land Surveyors or by a Decree Of a Court of Law; established, re-established, monumented, re-monumented, recovered, found as expressed below:

C-11 - Section corner common to Sections 29, 30, 31 & 32, T19N, R7W

A. Description of original monument and accessories and/or subsequent restoration:

1856 - F. Coleman, G.L.O.

- #1 - 10" Beech N54°E 8 Links
- #2 - Forked 12" Beech S66°W 48 Links

Undated Notes- M. McClung, LS 13037

Found two corners 3 feet apart (N. & S. of each other). The North being a wagon hub and tile. The South being a 3/4" rod. Accepted the tile.

1996 - R.L. Wetherell, LS 24624

- Found Capped Iron (LS 13037)
- #7 - 36" Maple N11°W 83.71'
- #5 - 7" Pipe Corner Post N40°W 42.60'
- #8 - 9" Tw. Maple S52°W 72.79'
- #6 - 9" Pipe Cor. Post S87°E 31.87'

1891 - 1904 - F. Trumbull, Co. Sur.

- Remonumentation of T19N, R7W. "Identified corner by stake". Set 3" Clay Tile with Cinders.
- #3 - 24" Pine N21°E 106 Links
- #4 22" Pine S73°W 89 1/2 Links

- #5 - 8" Pipe Fence Post N45°W 42.35'
- #6 - 8" Pipe Fence Post N88°E 30.65'

B. Description of corner evidence found and/or method applied in restoring of reestablishing corner:

I found a 3/4" Iron with Cap (LS 13037) inside an old wagon skein which was directly over a 3" Clay Tile with cinders. Corner is in the centerline of roads North, South and West. And is in line with fence to the East.


Condition of the accessories are as follows: #1 Gone, #2 Gone, #3 Gone, #4 Gone, #5 Found in good condition, #6 Found in good condition, #7 Found in good condition, #8 Found in good condition.

C. Description of monument for corner and accessories established to perpetuate locating the position of the corner:

I replaced the 3/4" Iron and Wagon Skein with a 1" x 18" Pipe with an Osceola County Remon Cap, and is accepted as a careful and faithful perpetuation of the position of the original corner.

- 36" Maple N11°W 83.71' (60d spike E. side) #7
- 7" Pipe Post N40°W 42.6' (center) #5
- 16" Tw. Maple S52°W 72.79' (60d spike N.W. side) #8
- 9" Pipe Post S87°E 31.87' (center) #6

APPROVED LAND CORNER
P.A. 345 OF 1990
Osceola County
R. L. W.
4-20-2000

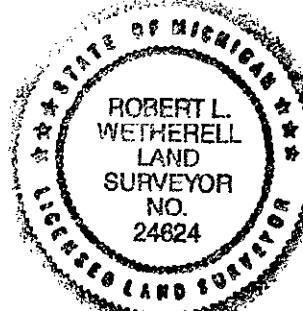

Signed by Robert L. Wetherell
Surveyor's Michigan License No. 24624

Date April 25, 2000

FORM APPROVED BY MICHIGAN STATE BOARD OF LAND SURVEYORS, JAN. 28, 1971
REVISED MAY 14, 1971
REVISED JAN., 1988
ADAPTED FOR WORD PROCESSING JANUARY, 1996