


SURVEY & REMONUMENTATION

DEC 13 2000

SECTION LAND CORNER RECORDATION CERTIFICATE
 FILING REQUIREMENT OF ACT 74, Mich. P.A. 1970

For corners in Osceola Located in: Corner Code#

1. Public Land Survey	T 19 N	R 7 W	D-9
	T	R	
	T	R	
	T	R	
2. Property Controlling in Section	S T	R	
	S T	R	
3. Miscellaneous Property in Sec.	S T	R	
	S T	R	
4. Lot No. _____ Recorded Plat _____			
5. Private Claims _____			

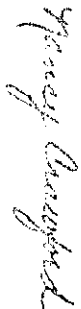
OSCEOLA COUNTY REGISTER OF DEEDS
00 MAY -5 PM 2:51
 Register of Deeds Stamp & File Number

	A	B	C	D	E	F	G	H	I	J	K	L	M
1													
2	6	5	4	3	2	1							
3													
4	7	8	9	10	11	12							
5													
6	18	17	16	15	14	13							
7													
8	19	20	21	22	23	24							
9													
10	30	29	28	27	26	25							
11													
12	31	32	33	34	35	36							
13													

I, Robert L. Wetherell, in a field survey on March 29, 2000, do hereby certify that under requirements of P.A. 74, Michigan P.A. of 1970, the corner points mentioned in lines 1 and 2 above were in conformance with regulations and rules therefore as required in the current manual of survey instructions of the United States Department of the Interior, Bureau of Land Management or by decree of a Court of Law and/or that the corner points mentioned in lines 3, 4, and 5 above were in conformance with the rules of the Michigan Board of Land Surveyors or by a Decree Of a Court of Law; established, re-established, monumented, re-monumented, recovered, found as expressed below:

D-9 - 1/4 Corner common to Sections 20 & 29, T19N, R7W

A. Description of original monument and accessories and/or subsequent restoration:

1856 - F. Coleman, G.L.O.

- #1 - 12" Beech N82°E 16 Links
- #2 - 22" W. Pine S44°W 42 Links

1891-1904 - F. Trumbull, Co. Sur.

- Remonumentation of T19N, R7W
- "Identified by O.B.T. and Stake".
- Set 3" Clay Tile with Cinders.
- #3 - 30" Pine N4½°E 28 Links
- #4 - 24" Pine S43°W 41 Links

1996 - R.L. Wetherell, LS 24624

- Found 3" Clay Tile with cinders and crockery with glass. Added ½" iron.
- #5 - 18" Maple N16°W 32.50'
- #6 - 10" Maple S42°E 32.55'
- #7 - 6" Ash N70°E 68.43'
- #8 - 4" Pipe Post S65°W 58.05'

B. Description of corner evidence found and/or method applied in restoring or reestablishing corner:

I found the ½" iron (I set in 1996) directly over the 3" clay tile (approximately 30" deep) corner is in the center of an old road bed East and West and in line with fence to North.


Condition of the accessories are as follows: #1 Gone #2 Found Stump, #3 Found remains of stump, #4 Gone, #5 Found in good condition, #6 Found in good condition, #7 Found in good condition, #8 Found in good condition.

C. Description of monument for corner and accessories established to perpetuate locating the position of the corner:

I replaced the ½" iron with a 1" x 18" pipe with Osceola County Remon Iron, and is accepted as a careful and faithful reestablishment of the position of the original corner.

- 18" Maple N16°W 32.50' (60d spike in W. side) #5
- 10" Maple S42°E 32.55' (60d spike in S.W. side) #6
- 6" Ash N70°E 68.43' (60d spike in S. side) #7
- 4" Pipe Post S65°W 58.05' (center) #8

APPROVED LAND CORNER
 P.A. 345 OF 1990
 Osceola County
R.L.W.
4-20-2000

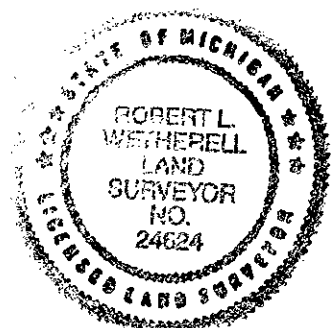

Signed by Robert L. Wetherell
 Surveyor's Michigan License No. 24624

Date April 25, 2000