

SURVEY & REMONUMENTATION

DEC 13 2000

SECTION

LAND CORNER RECORDATION CERTIFICATE

FILING REQUIREMENT OF ACT 74, Mich. P.A. 1970

For corners in <u>Osceola</u>	Located in:	Corner Code#
1. Public Land Survey	T 19 N R 7 W	F-1
	T R	
	T R	
	T R	
2. Property Controlling in Section	S T R	
	S T R	
3. Miscellaneous Property in Sec.	S T R	
	S T R	
4. Lot No. _____ Recorded Plat _____		
5. Private Claims _____		

OSCEOLA COUNTY
 REGISTER OF DEEDS
 00 MAY -5 PM 2:51
Spencer Campbell

Register of Deeds Stamp & File Number

	A	B	C	D	E	F	G	H	I	J	K	L	M
1													
2	6	5	4	3	2	1							
3													
4	7	8	9	10	11	12							
5													
6	18	17	16	15	14	13							
7													
8	19	20	21	22	23	24							
9													
10	30	29	28	27	26	25							
11													
12	31	32	33	34	35	36							
13													

I, Robert L. Wetherell, in a field survey on April 4, 2000, do hereby certify that under requirements of P.A. 74, Michigan P.A. of 1970, the corner points mentioned in lines 1 and 2 above were in conformance with regulations and rules therefore as required in the current manual of survey instructions of the United States Department of the Interior, Bureau of Land Management or by decree of a Court of Law and/or that the corner points mentioned in lines 3, 4, and 5 above were in conformance with the rules of the Michigan Board of Land Surveyors or by a Decree Of a Court of Law; established, re-established, monumented, re-monumented, recovered, found as expressed below:

F-1 - N. ¼ Corner Sec. 4, T19N, R7W - Common to S. ¼ Cor. Sec. 33, T20N, R7W

A. Description of original monument and accessories and/or subsequent restoration:

- | | | |
|--|--|--|
| <u>1837 - J. Hodgson, G.L.O.</u>
#1 - 7" Sugar N22°E 46 Links
#2 - 8" Ironwood N65°W 35 Links | <u>1891-1904 - F. Trumbull, Co. Sur.</u>
Remonumentation of Twp. T20N, R7W
Set 3" Clay Tile.
#3 - 6" Birch S25°E 9 ¼ Links
#4 - 4" Balsam N22½°E 39 1/3 Links | <u>1917 - Co. Sur. Twp. Notes</u>
"Tile".
#5 - 6" Pine N19½°W 85'
#6 - 6" Pine S64°W 88' |
|--|--|--|

B. Description of corner evidence found and/or method applied in restoring of reestablishing corner:

I found a ½" rod in center of clay tile with cinders. Corner is in the centerline of East and West road and in line with fence to the South.


Condition of the accessories are as follows: #1 Gone, #2 Gone, #3 Gone, #4 Gone, #5 Found in good condition, #6 Found 26" stump.

C. Description of monument for corner and accessories established to perpetuate locating the position of the corner:

I placed a 1" x 18" pipe with Osceola County Remon Cap over top of the ½" rod in center of tile, and is accepted as a careful and faithful reestablishment of the position of the original corner.

- 42" W. Pine N18°W 85.67' (60d spike E. side) #5
- 7" W. Pine N67°E 67.20' (60d spike S.E. side)
- T. Pole S03°E 51.78' (P.K. in W. side)
- 10"W. Pine S57°W 191.02' (60d spike S.E. side)

APPROVED LAND CORNER
P.A. 345 OF 1990
Osceola County
R.L.W.
4-20-2000

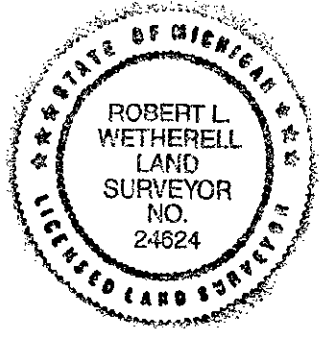

Signed by Robert L. Wetherell Date 4-25-2000
Surveyor's Michigan License No. 24624

FORM APPROVED BY MICHIGAN STATE BOARD OF LAND SURVEYORS, JAN.28, 1971
REVISED MAY 14, 1975
REVISED JAN., 1983
ADAPTED FOR WORD PROCESSING JANUARY, 1999