

**SURVEY &
REMONUMENTATION**

DEC 13 2000

SECTION LAND CORNER RECORDATION CERTIFICATE
FILING REQUIREMENT OF ACT 74, Mich. P.A. 1970

For corners in <u>Osceola</u>	Located in:	Corner Code#
1. Public Land Survey	T <u>19 N</u> R <u>7 W</u>	F-11
	T _____ R _____	_____
	T _____ R _____	_____
	T _____ R _____	_____
2. Property Controlling in Section	S _____ T _____ R _____	_____
	S _____ T _____ R _____	_____
3. Miscellaneous Property in Sec.	S _____ T _____ R _____	_____
	S _____ T _____ R _____	_____
4. Lot No. _____ Recorded Plat _____		
5. Private Claims _____		

OSCEOLA COUNTY
REGISTER OF DEEDS
00 MAY -5 PM 2:51
James Crawford

Register of Deeds Stamp & File Number

	A	B	C	D	E	F	G	H	I	J	K	L	M
1													
2	6	5	4	3	2	1							
3													
4	7	8	9	10	11	12							
5													
6	18	17	16	15	14	13							
7													
8	19	20	21	22	23	24							
9													
10	30	29	28	27	26	25							
11													
12	31	32	33	34	35	36							
13													

I, Robert L. Wetherell, in a field survey on March 20, 2000, do hereby certify that under requirements of P.A. 74, Michigan P.A. of 1970, the corner points mentioned in lines 1 and 2 above were in conformance with regulations and rules therefore as required in the current manual of survey instructions of the United States Department of the Interior, Bureau of Land Management or by decree of a Court of Law and/or that the corner points mentioned in lines 3, 4, and 5 above were in conformance with the rules of the Michigan Board of Land Surveyors or by a Decree Of a Court of Law; established, re-established, monumented, re-monumented, recovered, found as expressed below:

F-11 - 1/4 Corner Common to Sections 28 & 33, T19N, R7W

A. Description of original monument and accessories and/or subsequent restoration:

- | | | |
|--|--|--|
| <u>1856 - F. Coleman, G.L.O.</u>
#1 - 9" Beech N18°E 12 Links
#2 - 10 Beech S81°W 22 Links | <u>Undated Co. Sur. Twp. Book</u>
#5 - 4" Maple S51°E 49.5'
#6 - Measured East 2712.0' | <u>1998 - M. Robison, LS 27458</u>
L.C.R.C. - Liber 03, Pg. 189
"Found 3" Pipe".
#7 - 22" Maple N5°E 49.50'
#8 - 6" Ash N70°E 29.25'
#5 - 26" Maple S50°E 48.80'
#9 - 4" Pipe South 31.60' |
| <u>1891-1904 - F. Trumbull Co. Sur.</u>
"Identified by stump of O.B.T".
Set 3" Clay Tile
#3 - 16" Pine S48°W 69 2/3 Links
#4 - 20" Pine N70°W 91 Links | | |

B. Description of corner evidence found and/or method applied in restoring of reestablishing corner:

I found the 3" Clay Tile with cinders (14" below ground surface) next to a 3" pipe. Corner is 8 feet more or less North of the centerline of East and West two track road.


Condition of the accessories are as follows: #1 Gone, #2 Gone, #3 Gone, #4 Gone, #5 Found in good condition, #6 Did not measure, #7 Found in good condition, #8 Found in good condition, #9 Found in good condition.

C. Description of monument for corner and accessories established to perpetuate locating the position of the corner:

I set a 1" x 18" pipe with Osceola County Remon Cap in the center of the 3" clay tile and is accepted as a careful and faithful perpetuation of the position of the original corner.

- 4" Pipe Post South 31.75' (center) #9
- 17" Maple N1°W 49.20' (Nail & Cap E. side) #7
- 7" Ash N70°E 29.32' (60d spike in S. side) #8
- 26" Maple S47°E 49.24' (60d spike in N. side) #5)

APPROVED LAND CORNER
P.A. 345 OF 1990
Osceola County
R. L. W.
4-20-2000

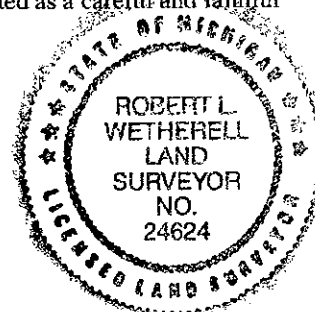

Signed by Robert L. Wetherell Date 4-25-2000
Surveyor's Michigan License No. 24624

FORM APPROVED BY MICHIGAN STATE BOARD OF LAND SURVEYORS, JAN. 28, 1971
REVISED MAY 14, 1975
REVISED JAN., 1983
ADAPTED FOR WORD PROCESSING JANUARY, 1999