

FEB 24 2000

SECTION

LAND CORNER RECORDATION CERTIFICATE  
Filing Requirement of Act 74, Mich. P.A. 1970

For corners in  
Osceola

(County)

Located In:

Corner Code #

1. Public Land Survey	T 19N	R 7W	J - 4
	T	R	
	T	R	
	T	R	
2. Property Controlling in Section	S	T	R
	S	T	R
3. Miscellaneous Property in Sec.	S	T	R
	S	T	R

OSCEOLA COUNTY  
REGISTER OF DEEDS  
99 NOV 19 PM 12:09  
*Walter Crawford*

Register of Deeds Stamp & File Number

4. Lot No. \_\_\_\_\_, Recorded Plat \_\_\_\_\_  
5. Private Claims \_\_\_\_\_

I, Robert L. Wetherell, in a field survey on Aug 11, 1999 do hereby state that under requirements of P.A. 74, Michigan P.A. of 1970, the corner points mentioned in lines 1 and 2 above were in conformance with regulations and rules therefore as required in the current manual of survey instructions of the United States Department of the Interior, Bureau of Land Management or by a decree of a Court of Law and/or that the corner points mentioned in lines 3, 4 and 5 above were in conformance with the rules of the Michigan Board of Land Surveyors or by a Decree of a Court of Law; established, re-established, monumented, recovered, found as expressed below:

NOTE: Not more than 2 corners, all in the same town and range, may be recorded on this certificate.

J-4 Center of Section 11, T19N, R7W

A. Description of original monument and accessories and/or subsequent restoration:

1998- McClung LS 13037

Set Osceola County Monument at intersection of 1/4 Lines  
Recorded Survey

- L. 649, Pg. 40
- #1 - 10" W. Pine S40E 5.65'
- #2 - 15" W. Pine S60W 40.60'
- #3 - 6" W. Pine S35W 22.0'
- #4 - 5" W. Pine N70E 27.05'

B. Description of corner evidence found and/or method applied in restoring or reestablishing corner:

I found an Osceola County Monument in line with fences East and West.

Condition of the accessories are as follows: #1 Found in good condition, #2 Found in good condition, #3 Found in good condition and #4 Found in good condition


C. Description of monument for corner and accessories established to perpetuate locating the position of the corner:

I accept the Osceola County Monument (1 1/2" Pipe with Osceola County Remon. Cap) as a substantial marker for the corner and is accepted as the best available evidence of the position of the original corner.

- 10" W. Pine S40E 5.50' (Nail on SE side) - #1
- 15" W. Pine S60W 40.81' (Nail on NW side) - #2
- 6" W. Pine S35W 22.14' (Nail on W side) - #3
- 5" W. Pine N70E 27.06' (Nail on S side) - #4

APPROVED LAND CORNER  
P.A. 345 OF 1990  
Osceola County

10-21-99  
R. L. W.

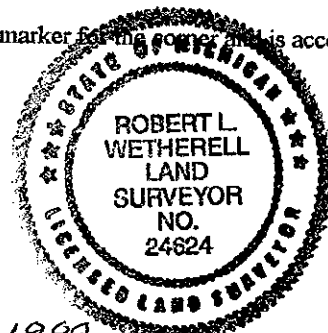

Signed by Robert L. Wetherell  
Surveyor's Michigan License No. 24624

Date Nov. 9, 1999