

SURVEY &
REMONUMENTATION

SEP 10 1998

LAND CORNER RECORDATION CERTIFICATE
Filing Requirement of Act 74, Mich. P.A. 1970

SECTION

For corners in

Osceola

(County)

Located In:

Corner Code #

1. Public Land Survey

T 19 R 7W M-5

T R

T R

T R

2. Property Controlling
in Section

S T R

S T R

3. Miscellaneous
Property in Sec.

S T R

S T R

APPROVED LAND CORNER
P.A. 345 OF 1990
Osceola County

28 May 1998
Matthew M. McClung

Register of Deeds Stamp & File Number

4. Lot No. _____, Recorded Plat _____

5. Private Claims _____

I, Matthew McClung in a field survey on 5-25, 1998 do hereby state that under requirements of P.A. 74, Michigan P.A. of 1970, the corner points mentioned in lines 1 and 2 above were in conformance with regulations and rules therefore as required in the current manual of survey instructions of the United States Department of the Interior, Bureau of Land Management or by a decree of a Court of Law and/or that the corner points mentioned in lines 3, 4 and 5 above were in conformance with the rules of the Michigan Board of Land Surveyors or by a Decree of a Court of Law; established, re-established, monumented, recovered, found as expressed below:

NOTE: Not more than 2 corners, all in the same town and range, may be recorded on this certificate.

	A	B	C	D	E	F	G	H	I	J	K	L	M
1													
2	6		5		4		3		2		1		
3													
4	7		8		9		10		11		12		
5													
6	18		17		16		15		14		13		
7													
8	19		20		21		22		23		24		
9													
10	30		29		28		27		26		25		
11													
12	31		32		33		34		35		36		
13													

A. Description of original monument and accessories and/or subsequent restoration:

The corner was set by deputy surveyor John Hodgson on Dec. 7, 1856. Set Post Corner 80.00 chains from the South. (resurvey)

Pine 10" S31W 43 lks.

Pine 8" N57W 74 lks.

From 1891 to 1904 approximately, Osceola County had a remonumentation program, in which surveyors Temple and Trumbull, did the work. For the most part, a 3" glazed tile filled with cinders from a forge, were placed at each government set corner in the township. There were supposed to be 3 tile per corner, placed atop of each other, (continued on back)


B. Description of corner evidence found and/or method applied in restoring or reestablishing corner:

Found Monument Box in C/L of M-61. Found State Monument.

C. Description of monument for corner and accessories established to perpetuate locating the position of the corner:

Corner K-4 is a MDSH&T monument.

DNR Post North 50.35 feet.
East end of Culvert S12E 43.3 feet.
West end of Culvert S20W 46.9 feet.
Red Pine 16" N50E 175.9 feet.

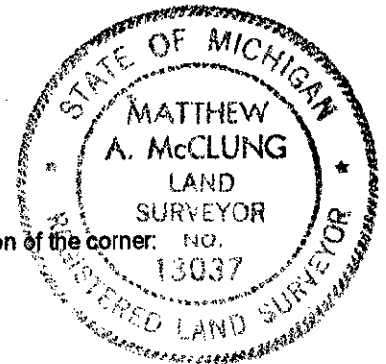

Signed by Matthew M. McClung 13037
Surveyor's Michigan License No. _____

Date 23 July 1998

OSCEOLA COUNTY
REGISTER OF DEEDS

98 JUL 23 PM 12:41

Nancy Crawford

SURVEY &
REMONUMENTATION

SEP 10 1998

SECTION

thereby making the corner 4 feet long. Sometimes a solid tile, with a cross in the top was used, and sometimes a 1/2" iron bars were added to the tile. Notes of the work were kept in ledgers, and given to the townships, and 5 of the townships have been entered in the County surveyors records.

MDSH&T Corner card.
Found Axle Shaft beside
old (decayed wood stake.
13" J. Pine S45W 79.95'
10" J. Pine S40E 59.82'
8" J. Pine North 54.93'

Act. 74.
Liber 1, page 356, by McClung
Fd. Mon. box in M-61
Mon. box in M-61

Act 74
Liber 2 Page 157 by Fluharty
Fd 5/8" w/metal cap
5/8" with metal cap