LAND CORNER RECORDATION CERTIFICATE

Filing Requirement of Act 74, Mich. P.A. 1970

For corners in
OSCEOLA
(County)

	Located In:	Corner Code ##
1. Public Land Survey	T 19N R 8W	A-10
	T ____ R ____	B-9
	T ____ R ____	
	T ____ R ____	
2. Property Controlling	S 30 T ____ R ____	5, 3
in Section	S ____ T ____ R ____	
3. Miscellaneous	S ____ T ____ R ____	
Property in Sec.	S ____ T ____ R ____	

Register of Deeds Stamp & File Number

4. Lot No. _____ , Recorded Plat _____
5. Private Claims _____

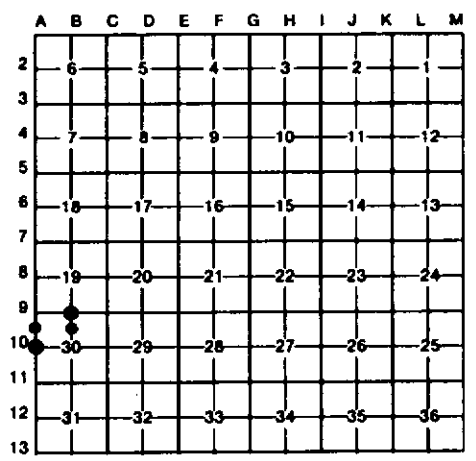

I, CARL F. ROSER , in a field survey on FEBRUARY 9, , 19 88 , do hereby certify that under requirements of P.A. 74, Michigan P.A. of 1970, the corner points mentioned in lines 1 and 2 above were in conformance with regulations and rules therefore as required in the current manual of survey instructions of the United States Department of the Interior, Bureau of Land Management or by a decree of a Court of Law and/or that the corner points mentioned in lines 3, 4 and 5 above were in conformance with the rules of the Michigan Board of Land Surveyors or by a Decree of a Court of Law; established, re-established, monumented, re-monumented, recovered, found as expressed below:

NOTE: Not more than 4 corners, all in the same town and range, may be recorded on this certificate.

A. Description of original monument and accessories and/or subsequent restoration:

A-10	B-9	5	3

B. Description of corner evidence found and/or method applied in restoring or reestablishing corner:

A-10	B-9	5	3
FD OLD 1/2" IRON ROD IN 3" VIT TILE AS NOTED BY CO SURVEYOR, A. TEMPLE IN 1892. FD REMAINS OF 1 TEMPLE WIT. COR IS N40 E 110'(±20') FROM APPROX CTR 80'± X 135'± SWP, W/WATER & CAT-TAILS. COR IS ON SOLID GRD. TEMPLE NOTES SAY, OLD WIT MAPLE DEAD BUT STANDING & B OAK DOWN.	FD OSCEOLA CO. MON IN TILE; SET BY RLS, MATT MCCLUNG IN 1973. CO SURVEYOR, A.TEMPLE, REMONUMENTED W/TILE IN 1892. MON IS AT OLD STANDING FN COR W/FNS N & E FD & USED 3 MCCLUNG (1973) BTS. THESE ARE THE SAME AS, RLS, H. FLUHARTY (1976) BTS..	ESTABLISH NE COR, S1/2-NW1/4, SEC.30 PER STD. BLM INSTRUCTIONS..	ESTABLISH NW COR, S1/2-NW 1/4, SEC.30 PER STD. BLM INSTRUCTIONS.

C. Description of monument for corner and accessories established to perpetuate locating the position of the corner:

A-10			B-9			5			3		
FD 1/2" IRON RD IN TILE; ADDED CEDAR POST W/LOC TAG.			FD OSCEOLA CO MON OVER STEEL FN POST IN TILE;ADDED CED POST			DROVE 5/8"X34" RE-ROD W/RLS CAP & SET CED POST.			DROVE 5/8"X34" RE-ROD W/RLS CAP & SET CED POST W/LOC TAG.		
14" B Cherry			18" R OAK	N50°E	31.43'	6" MAPLE	S80°E	17.6'	10" MAPLE	S65°W	35.7'
(CLP 5)	N45°E	29.1'	16" MAPLE	S40°W	42.71'	10" R.OAK	S30°E	6.0'	8" R OAK	N55°W	50.2'
24" MAPLE	S25°E	35.3'	16" R OAK	N70°W	33.28'	4" R.OAK	S55°W	18.8'	N-S TRV LINE	DUE E	36'
16" MAPLE	S30°W	15.0'				FD 5/8"REROD,COR					
32" R OAK	S70°W	32.7'				LOTS 5/10	S02°42'E	19.92'			

Signed by Carl F. Roser 02-05-91 Date _____

Surveyor's Michigan License No. 12028

STATE OF MICHIGAN
CARL F. ROSER
LAND SURVEYOR
No. 12028
REGISTERED LAND SURVEYOR

FORM APPROVED BY MICHIGAN STATE BOARD ... 28, 1971
... MAY 14, 1975
REVISED JAN., 1983