

**SURVEY &  
REMONUMENTATION**


DEC 13 2000

SECTION

**LAND CORNER RECORDATION CERTIFICATE**

FILING REQUIREMENT OF ACT 74, Mich. P.A. 1970

For corners in <u>Osceola</u>	Located in:	Corner Code#
1. Public Land Survey	<u>T 19 N R 8 W</u>	<u>A-4</u>
	<u>T</u>	<u>R</u>
	<u>T</u>	<u>R</u>
	<u>T</u>	<u>R</u>
2. Property Controlling in Section	<u>S T R</u>	
	<u>S T R</u>	
3. Miscellaneous Property in Sec.	<u>S T R</u>	
	<u>S T R</u>	
4. Lot No. <u>    </u> Recorded Plat <u>    </u>		
5. Private Claims <u>    </u>		

  
**OSCEOLA COUNTY  
REGISTER OF DEEDS**  
**00 MAY -5 PM 2:51**  
 Register of Deeds Stamp & File Number

	A	B	C	D	E	F	G	H	I	J	K	L	M
1													
2	6	5	4	3	2	1							
3													
4	7	8	9	10	11	12							
5													
6	18	17	16	15	14	13							
7													
8	19	20	21	22	23	24							
9													
10	30	29	28	27	26	25							
11													
12	31	32	33	34	35	36							
13													

I, Robert L. Wetherell, in a field survey on April 10, 2000, do hereby certify that under requirements of P.A. 74, Michigan P.A. of 1970, the corner points mentioned in lines 1 and 2 above were in conformance with regulations and rules therefore as required in the current manual of survey instructions of the United States Department of the Interior, Bureau of Land Management or by decree of a Court of Law and/or that the corner points mentioned in lines 3, 4, and 5 above were in conformance with the rules of the Michigan Board of Land Surveyors or by a Decree Of a Court of Law; established, re-established, monumented, re-monumented, recovered, found as expressed below:

A-4 - W. 1/4 corner Sec. 7, T19N, R8W - E. 1/4 corner Sec. 12 T19N, R9W

**A. Description of original monument and accessories and/or subsequent restoration:**

- |  |  |   |
|--|--|---|
| <p><b>1838 - J. Hodgson, G.L.O.</b><br/>         #1 - 22" Hemlock S69°W 22 Links<br/>         #2 - 16" Hemlock N65°W 39 Links</p>  | <p><b>1983 - M. McClung, LS 13037</b><br/>         L.C.R.C. - Liber 02, Pg. 210<br/>         Survey recorded Liber 404, Pg. 72<br/>         Found Clay and Tile and Cinders.<br/>         #5 - P. Pole S89°E 118.50'</p> | <p><b>1990 - M. McClung, LS 13037</b><br/>         Survey recorded Liber 532, Pg. 786.<br/>         #5 - P. Pole S89°E 118.5'</p> |
| <p><b>1892 - A.O. Temple, Co. Sur.</b><br/>         "Found both U.S. B.T's".<br/>         Set Clay Tile.<br/>         #3 - 40" Pine Stump N88°E 174 Links<br/>         #4 - 10" Bccch N80°E 50 Links</p> | <p><b>1988 - R.L. Wetherell, LS 24624</b><br/>         Found Tile and Iron.<br/>         #5 - P. Pole S85°E 118.80'</p>  |   |

**B. Description of corner evidence found and/or method applied in restoring of reestablishing corner:**

I found a 1/2" Iron in 3" Clay Tile in line with old fence to East and 6 feet more or less West of the centerline of road North and South.


Condition of the accessories are as follows: #1 Gone, #2 Gone, #3 Gone, #4 Gone, #5 Found in good condition.

**C. Description of monument for corner and accessories established to perpetuate locating the position of the corner:**

I replaced the 1/2" Iron with a 1" x 18" Iron Pipe with Osceola County Remon Cap, and is accepted as a careful and faithful perpetuation of the position of the original corner.

- P. Pole N24°E 414.72' (P.K. Nail W. side)
- P. Pole S84°E 118.75' (60d spike S. side) #5
- 6" Cherry S20°E 64.04' (60d spike W. side)
- 8" R. Pine S02°E 309.14' (60d spike E. side)

APPROVED LAND CORNER  
 P.A. 345 OF 1990  
 Osceola County  
R. L. W.  
4-20-2000

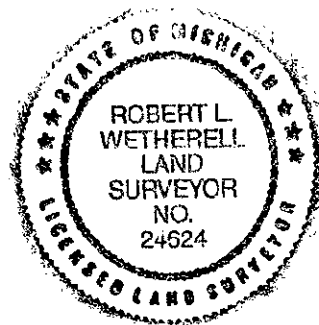

Signed by Robert L. Wetherell  
 Surveyor's Michigan License No. 24624

Date April 25, 2000

FORM APPROVED BY MICHIGAN STATE BOARD OF LAND SURVEYORS, JAN. 28, 1971  
 REVISED MAY 14, 1975  
 REVISED JAN. 1983  
 ADAPTED FOR WORD PROCESSING JANUARY, 1999