

**SURVEY &
REMONUMENTATION**

DEC 13 2000

SECTION

LAND CORNER RECORDATION CERTIFICATE

FILING REQUIREMENT OF ACT 74, Mich. P.A. 1970

For corners in
Osceola

Located in: Corner Code#

- | | | | |
|---------------------------------------|--------|-------|-----|
| 1. Public Land Survey | T 19 N | R 8 W | A-5 |
| | T | R | |
| | T | R | |
| | T | R | |
| 2. Property Controlling
in Section | S T | R | |
| | S T | R | |
| 3. Miscellaneous
Property in Sec. | S T | R | |
| | S T | R | |
| 4. Lot No. _____ Recorded Plat _____ | | | |
| 5. Private Claims _____ | | | |

OSCEOLA COUNTY
 REGISTER OF DEEDS
 00 MAY -5 PM 2:51
George Campbell
 Register of Deeds Stamp & File Number

I, Robert L. Wetherell, in a field survey on April 10, 2000, do hereby certify that under requirements of P.A. 74, Michigan P.A. of 1970, the corner points mentioned in lines 1 and 2 above were in conformance with regulations and rules therefore as required in the current manual of survey instructions of the United States Department of the Interior, Bureau of Land Management or by decree of a Court of Law and/or that the corner points mentioned in lines 3, 4, and 5 above were in conformance with the rules of the Michigan Board of Land Surveyors or by a Decree of a Court of Law; established, re-established, monumented, re-monumented, recovered, found as expressed below:

	A	B	C	D	E	F	G	H	I	J	K	L	M
1													
2	6	5	4	3	2	1							
3													
4	7	8	9	10	11	12							
5													
6	18	17	16	15	14	13							
7													
8	19	20	21	22	23	24							
9													
10	30	29	28	27	26	25							
11													
12	31	32	33	34	35	36							
13													

A-5 - Sec. Cor. common to Section 7 & 18, T19N, R8W
Sec. cor. common to Sections 12 & 13, T19N, R9W

A. Description of original monument and accessories and/or subsequent restoration:

1838 - J. Hodgson, G.L.O.

- #1 - 10" Hemlock S34°W 9 Links
- #2 - 9" Hemlock N80°W 8 Links

Undated Co. Sur. Twp. Notes

- "Iron & Tile".
- #4 - 3" Elm S.E. 73'
- #5 - Maple S.W. 33½'
- #6 - Distance West 2508'
- #7 - Distance South 2621'
- #8 - R.E.A. - N.W. 86.5'

1980 - M. McClung, LS 13037

- L.C.R.C. - Liber 02, Pg. 169.
- Found Tile & Iron.
- #4 - 3" Elm S.E. 73'
- #8 - P. Pole N.W. 86.5'

1892 - A.O. Temple, Co. Sur.

- Remonumentation of T19N, R9W
- Found both original B.T's.
- Set 3" Clay Tile with Cinders
- #3 - 20" Maple - East 23 Links

1953 - G. Blass, LS 5489

- Found 3" Clay Tile - Set ½" Pipe in center.
- #12 - 14" Elm S10°E 100.35'
- #13 - 6" El S48°W 93.00'
- #14 - Fence Post N44°W 48.10'

1988 - R.L. Wetherell, LS 24624

- Found ½" Pipe over top of 3" Clay Tile.
- #9 - 6" W. Birch N50°E 28.59'
- #10 - 3" Maple S50°W 49.60'
- #11 - 6" Tri. Maple N59°W 63.86'

B. Description of corner evidence found and/or method applied in restoring or reestablishing corner:

I found a ½" Pipe over a 3" Clay Tile with cinders. Corner is 3 feet more or less West of centerline of road North and South and in line with centerline of road to West.

Condition of the accessories are as follows: #1 Gone, #2 Gone, #3 Gone, #4 Gone, #5 Gone, #6 Measured 2510', #7 Did not measure, #8 Found in good condition, #9 Found in good condition, #10 Found in good condition, #11 Found in good condition, #12 Found Stump, #13 Found in good condition, #14 Found leaning.


C. Description of monument for corner and accessories established to perpetuate locating the position of the corner:

I replaced the ½" Pipe with a 1" x 18" Pipe with Osceola County Remon Cap, and is accepted as a careful and faithful perpetuation of the position of the original corner.

- P. Pole N16°W 86.94' (P.K. Nail E. side) #8
- 16" Maple S6°E 94.64' (60d spike E. side)
- 9" Birch N50°E 28.59' (60d spike N.W. side) #9
- 8" Maple S50°W 49.60' (60d spike S.E. side) #10
- 7" Tri. Maple N59°W 63.95' (60d spike S. side) #11

APPROVED LAND CORNER
 P.A. 345 OF 1990
 Osceola County

R.L.W.
4-20-2000

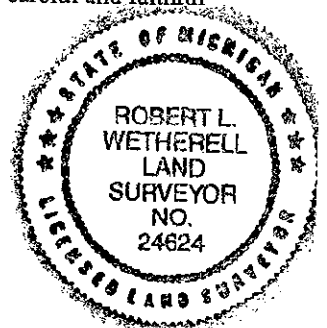

Signed by Robert L. Wetherell
 Surveyor's Michigan License No. 24624

Date April 25, 2000

FORM APPROVED BY MICHIGAN STATE BOARD OF LAND SURVEYORS, JAN. 28, 197
 REVISED MAY 14, 197
 REVISED JAN. 198
 ADAPTED FOR WORD PROCESSING JANUARY, 198