

# SURVEY & REMONUMENTATION

SEP 15 1994

LAND CORNER RECORDATION CERTIFICATE

LIBER A PAGE 186

COMMISSION

Filing Requirement of Act 74, Mich. P.A. 1970

For corners in  
Osceola  
(County)

Located In: Corner Code #

1. Public Land Survey	T <u>19N</u> R <u>8W</u>	_____	H-9	
	T _____ R _____	_____	_____	
	T _____ R _____	_____	_____	
	T _____ R _____	_____	_____	
2. Property Controlling in Section	S _____ T _____ R _____	_____	_____	
	S _____ T _____ R _____	_____	_____	
3. Miscellaneous Property in Sec.	S _____ T _____ R _____	_____	_____	
	S _____ T _____ R _____	_____	_____	

**APPROVED LAND CORNER**  
P.A. 345 OF 1990  
Osceola County

*Matthew McClung*  
26 July 1994

Register of Deeds Stamp & File Number

4. Lot No. \_\_\_\_\_, Recorded Plat \_\_\_\_\_  
5. Private Claims \_\_\_\_\_

I, Matthew McClung a field survey on 25 July, 191994

do hereby certify that under requirements of P.A. 74, Michigan P.A. of 1970, the corner points mentioned in lines 1 and 2 above were in conformance with regulations and rules therefore as required in the current manual of survey instructions of the United States Department of the Interior, Bureau of Land Management or by a decree of a Court of Law and/or that the corner points mentioned in lines 3, 4 and 5 above were in conformance with the rules of the Michigan Board of Land Surveyors or by a Decree of a Court of Law; established, re-established, monumented, re-monumented, recovered, found as expressed below:

**NOTE: Not more than 4 corners, all in the same town and range, may be recorded on this certificate.**

A. Description of original monument and accessories and/or subsequent restoration:

The corner was set by deputy surveyor Sylvester Sibley on July 7, 1838. Set wood post 39.91 chains from the East.

Sugar 8" S49W 14 lks.

Sugar 6" N44E 32 lks.

From 1891 to 1904 approximately, Osceola County had a remonumentation program, in which surveyors Temple and Trumbull, did the work. For the most part, a 3" glazed tile filled with cinders from a forge, were placed at each government set corner in the township. There were supposed to be 3 tile per corner, placed atop of each other, (continued on back)

B. Description of corner evidence found and/or method applied in restoring or reestablishing corner:

Found 1/2" re-rod 2" below road surface. Excavated to 11" and found 7/8" rod with top 6" bent to west. 1/2" bar was at top of 7/8" iron. At 13" below surface found 3" tile on east side of 7/8" rod. Placed Osceola County Monument in tile 3" below road surface.

C. Description of monument for corner and accessories established to perpetuate locating the position of the corner:

Corner H-9. is Osceola County Monument, which is a 3" brass cap mounted on a 1" pipe 18" in length.


Power pole N75E 86.87 feet.

6" W. Pine S50E 118.40 feet

Iron and cap 14102 S02W 33.02 feet.

17" R. Oak S52W 71.61 feet.

	A	B	C	D	E	F	G	H	I	J	K	L	M
2	6	5	4	3	2	1							
3													
4	7	8	9	10	11	12							
5													
6	18	17	16	15	14	13							
7													
8	19	20	21	22	23	24							
9													
10	30	29	28	27	26	25							
11													
12	31	32	33	34	35	36							
13													

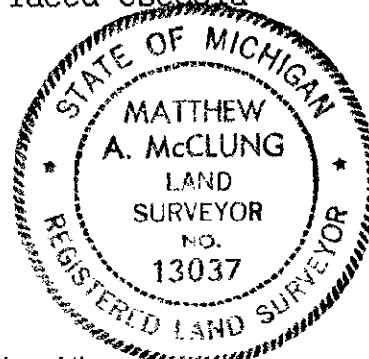

Signed by Matthew McClung

Date July 25, 1994

Surveyor's Michigan License No. 13037

OSCEOLA COUNTY  
REGISTER OF DEEDS

94 AUG 19 PM 3: 29

*Nancy Crawford*

thereby making the corner 4 feet long. Sometimes a solid tile, with a cross in the top was used, and sometimes a 1/2" iron bars were added to the tile. Notes of the work were kept in ledgers, and given to the townships, and 5 of the townships have been recorded in the County records.

One Page from the Township book shows the corner to be tile, dated 1942.

Two PA. 132 certificates by Cole and Wilcox.