

**SURVEY &
REMONUMENTATION**

JUN 09 1997

LAND CORNER RECORDATION CERTIFICATE
Filing Requirement of Act 74, Mich. P.A. 1970

For corners in

COMMISSION

| | | |
|---------------------------------------|-------------------------|---------------|
| <u>Osceola</u> (County) | Located In: | Corner Code # |
| 1. Public Land Survey | T <u>19</u> R <u>8W</u> | <u>K-3</u> |
| | T ___ R ___ | _____ |
| | T ___ R ___ | _____ |
| | T ___ R ___ | _____ |
| 2. Property Controlling in Section | S ___ T ___ R ___ | _____ |
| | S ___ T ___ R ___ | _____ |
| 3. Miscellaneous Property in Sec. | S ___ T ___ R ___ | _____ |
| | S ___ T ___ R ___ | _____ |

APPROVED LAND CORNER
P.A. 345 OF 1990
Osceola County

Matthew McClung
24 April 1997

Register of Deeds Stamp & File Number

4. Lot No. _____, Recorded Plat _____
5. Private Claims _____

Matthew McClung, in a field survey on Apr 16 1997 do hereby state that under requirements of P.A. 74, Michigan P.A. of 1970, the corner points mentioned in lines 1 and 2 above were in conformance with regulations and rules therefore as required in the current manual of survey instructions of the United States Department of the Interior, Bureau of Land Management or by a decree of a Court of Law and /or that the corner points mentioned in lines 3, 4 and 5 above were in conformance with the rules of the Michigan Board of Land Surveyors or by a Decree of a Court of Law; established, re-established, monumented, recovered, found as expressed below:

NOTE: Not more than 2 corners, all in the same town and range, may be recorded on this certificate.

| A | B | C | D | E | F | G | H | I | J | K | L | M |
|----|----|---|----|---|----|---|----|---|----|---|----|---|
| 1 | | | | | | | | | | | | |
| 2 | 6 | | 5 | | 4 | | 3 | | 2 | | 1 | |
| 3 | | | | | | | | | | | | |
| 4 | 7 | | 8 | | 9 | | 10 | | 11 | | 12 | |
| 5 | | | | | | | | | | | | |
| 6 | 18 | | 17 | | 16 | | 15 | | 14 | | 13 | |
| 7 | | | | | | | | | | | | |
| 8 | 19 | | 20 | | 21 | | 22 | | 23 | | 24 | |
| 9 | | | | | | | | | | | | |
| 10 | 30 | | 29 | | 28 | | 27 | | 26 | | 25 | |
| 11 | | | | | | | | | | | | |
| 12 | 31 | | 32 | | 33 | | 34 | | 35 | | 36 | |
| 13 | | | | | | | | | | | | |

A. Description of original monument and accessories and/or subsequent restoration:

The corner was set by deputy surveyor Sylvester Sibley on July 7, 1838. Set wood post 80.00 chains from the South.

Y. Pine 14" N15E 7 Lks.

Elm 7" S40W 8 Lks..

From 1891 to 1904 approximately, Osceola County had a remonumentation program, in which surveyors Temple and Trumbull, did the work. For the most part, a 3" glazed tile filled with cinders from a forge, were placed at each government set corner in the township. There were supposed to be 3 tile per corner, placed atop of each other, (continued on back)


B. Description of corner evidence found and/or method applied in restoring or reestablishing corner:

Excavated to 6" and found 1/2" rod. Excavated to 8" and ^{found} Tile. Placed Osceola County Monument over rod in tile 6" below road surface. 3 feet West of center line.

C. Description of monument for corner and accessories established to perpetuate locating the position of the corner:

Corner K-3. is Osceola County Monument, which is a 3" brass cap mounted on a 1" pipe 18" in length.

- Power Pole N60W 52.5 feet. With Nail
- Top of Guy on Power Pole N46W 47.9 feet.
- Fence Post East 34.54 feet.
- Fence Post S58E 35.00 feet. With Nail

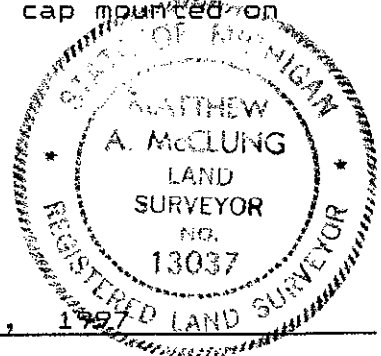

Signed by *Matthew McClung*
Surveyor's Michigan License No. 13037

Date April 16, 1997

thereby making the corner 4 feet long. Sometimes a solid tile, with a cross in the top was used, and sometimes a 1/2" iron bars were added to the tile. Notes of the work were kept in ledgers, and given to the townships, and 5 of the townships have been entered in the County surveyors records

Hartwick Township Records Book; Front pages. (Tile) Post S10E 30.8 feet-F.P. NW 39.6 feet.

OSCEOLA COUNTY
REGISTER OF DEEDS

97 APR 30 PM 12:32

Wayne Crawford

31

SURVEY &
REMONUMENTATION

JUN 09 1997

COMMISSION