

FEB 24 2000

**LAND CORNER RECORDATION CERTIFICATE**

FILING REQUIREMENT OF ACT 74, Mich. P.A. 1970

**SECTION**

For corners in <u>Osceola</u>	Located in:	Corner Code#
1. Public Land Survey	T 19N R 8W	K-5
	T R	
	T R	
	T R	
2. Property Controlling in Section	T R	
	S T R	
3. Miscellaneous Property in Sec.	S T R	
	S T R	
4. Lot No. _____ Recorded Plat		
5. Private Claims		

Register of Deeds Stamp & File Number

	A	B	C	D	E	F	G	H	I	J	K	L	M
1													
2	6	5	4	3	2	1							
3													
4	7	8	9	10	11	12							
5													
6	18	17	16	15	14	13							
7													
8	19	20	21	22	23	24							
9													
10	30	29	28	27	26	25							
11													
12	31	32	33	34	35	36							
13													

I, Robert L. Wetherell, in a field survey on October 1 1999, do hereby certify that under requirements of P.A. 74, Michigan P.A. of 1970, the corner points mentioned in lines 1 and 2 above were in conformance with regulations and rules therefore as required in the current manual of survey instructions of the United States Department of the Interior, Bureau of Land Management or by decree of a Court of Law and/or that the corner points mentioned in lines 3, 4, and 5 above were in conformance with the rules of the Michigan Board of Land Surveyors or by a Decree Of a Court of Law; established, re-established, monumented, re-monumented, recovered, found as expressed below:

**NOTE: ONLY ONE CORNER MAY BE RECORDED ON THIS CERTIFICATE.**

**Sec. Corner Common to Sec's 11-12-13-14**

**A. Description of original monument and accessories and/or subsequent restoration:**

<u>1838 S. Sibley</u>	<u>1891-1904-A. Temple/F. Trumbull</u>	<u>Undated- Hartwick Twp Book</u>
#1- Beech S51E 10 Lk.	Remonumentation of T19N-R8W	Page 3 Front Pages Steigh Shoe
#2- 13" Beech N78 1/2 W 16 Lk.	Set 3" Clay Tile	#4- 4" Maple S27E 75.'
		#5- 4" Maple S41W 26 1/2'

**(SEE OVER FOR CONTINUATION OF "A")**

**B. Description of corner evidence found and/or method applied in restoring of reestablishing corner:**


I found an Osceola County Monument, +/- 3' West of the C/L of North and South road and +/- 3' North of C/L of Seasonal Road to the East.

Condition of the accessories are as follow: #1 Gone, #2 Gone, #4 Found, #5 Gone, #7 Gone, #8 Found in good condition #9 Found in good condition, #10 Found in good condition and #11 Found in good condition

**C. Description of monument for corner and accessories established to perpetuate locating the position of the corner:**

I accept the Osceola County Monument (1 1/2" pipe with an Osceola County Remon Cap) as a substantial marker of the corner and is accepted as a careful and faithful reestablishment of the position of the original corner.

P. Pole S57E 191.1'(Center) - #8  
 3" Dbl. Apple S75E 89.60'(Nail in N. side) - #9  
 Tele. Ped.N12W 143.45'(Top Center) - #10  
 6" Elm N10W 172.97'(Nail in E. side) - #11

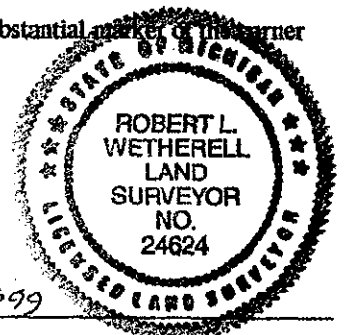

Signed by Robert L. Wetherell

Date Nov. 9, 1999

Surveyor's Michigan License No. 24624

APPROVED LAND CORNER  
 P.A. 74 OF 1990  
 Osceola County

10-21-99

R. L. W.

CONTINUATION OF DESCRIPTION OF THE ORIGINAL MONUMENT AND ACCESSORIES AND/OR SUBSEQUENT AND RESTORATION.

1942 Hartwick Two Book

Pages 60 & 61  
Distance East 2626.'

1976 McClung LS 13037

Fd. Sleigh Shoe  
#4- 12" Maple Se 75.0'  
#7- 3" Butternut Hickory SW 90.0'

1997 McClung LS 13037

Fd. Sleigh Shoe  
Set Osceola County Monument  
#8- P. Pole S57E 191.1'  
#9- 3" Dbl. Apple S75E 89.9'  
#10- Tele. Ped. N12W 143.45'  
#11- 6" Elm N10W 172.5'  
Distance East 2654.05'

SURVEY &  
RECORDS  
FEB 24 2000  
SECTION

OSCEOLA COUNTY  
REGISTER OF DEEDS  
99 NOV 19 PM 12:09  
*Nancy Crawford*