

NOV 01 1999

SECTION

LAND CORNER RECORDATION CERTIFICATE
Filing Requirement of Act 74, Mich. P.A. 1970

For corners in
Osceola

Located In:	Corner Code #
(County)	
19N 8W	L-7
1. Public Land Survey	T___ R___
	T___ R___
	T___ R___
	T___ R___
2. Property Controlling in Section	S___ T___ R___
	S___ T___ R___
3. Miscellaneous Property in Sec.	S___ T___ R___
	S___ T___ R___

Register of Deeds Stamp & File Number

4. Lot No. _____, Recorded Plat _____
5. Private Claims _____

I, Robert L. Wetherell, in a field survey on Aug 11, 1999 do hereby state that under requirements of P.A. 74, Michigan P.A. of 1970, the corner points mentioned in lines 1 and 2 above were in conformance with regulations and rules therefore as required in the current manual of survey instructions of the United States Department of the Interior, Bureau of Land Management or by a decree of a Court of Law and /or that the corner points mentioned in lines 3, 4 and 5 above were in conformance with the rules of the Michigan Board of Land Surveyors or by a Decree of a Court of Law, established, re-established, monumented, recovered, found as expressed below:

NOTE: Not more than 2 corners, all in the same town and range, may be recorded on this certificate.

L-7 - S 1/4 Corner of Section 13, T19N, R8W

	A	B	C	D	E	F	G	H	I	J	K	L	M
1													
2		6		5		4		3		2		1	
3													
4		7		8		9		10		11		12	
5													
6		18		17		16		15		14		13	
7													
8		19		20		21		22		23		24	
9													
10		30		29		28		27		26		25	
11													
12		31		32		33		34		35		36	
13													

A. Description of original monument and accessories and/or subsequent restoration:

1838 - Sibley
#1- 10" Fir N5W 12 Lks.
#2- 12" Fir S10E 11 Lks

1891 - 1904 - A. Temple/F.Trumbull
Remonumentation of T19N, R8W
Set 3" Clay tiles

Undated Hartwick Twp Book
Front Pages Page 4
1/4 13 & 24 Tile.
3- Pine S10W 49.7'
4- Distance East = 2649.2'

(SEE OVER FOR CONTINUATION OF "A")

B. Description of corner evidence found and/or method applied in restoring or reestablishing corner:


Found McClung's Osceola County Monument.

Condition of the accessories are as follows: #1 Gone, #2Gone, #3Fd. Stump, #4 Distance East 2643.16', #5, Found in good condition #6 Found in good condition, #7 Found in good condition and #8 Found in good condition.

C. Description of monument for corner and accessories established to perpetuate locating the position of the corner:

I accept Osceola County Monument (1 1/2" Pipe with Osceola County Remon Cap) as a substantial marker for the corner and is accepted as a careful and faithful reestablishment of the position of the original corner.

5" Elm N48E 33.1' #5
Center Iron F. Post South 34.5' #6
3" W. Pine S58W 65.2' #7
4" W. Pine S64W 97.55' #8
Pine Stump S10W 47.8' #3

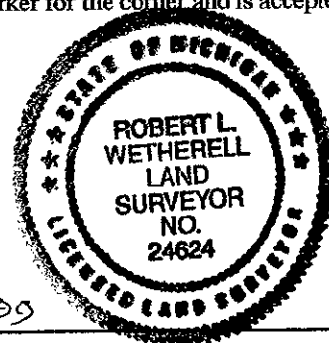

Signed by Robert L. Wetherell
Surveyor's Michigan License No. 24624

Date 8-26-99

APPROVED LAND CORNER
P.A. 345 OF 1990
Osceola County

8-26-99

CONTINUATION OF DESCRIPTION OF ORIGINAL MONUMENT AND ACCESSORIES AND/OR SUBSEQUENT RETORATION.

1998 - McClung LS 13037

Survey Record

L. 622, Pg. 721

Fd. Iron rod

Set Osceola County Monument

#5 - 5" Elm N48E 33.1'

#6 - Center Iron F. Post South 34.5'

#7 - 3" W. Pine S58W 65.2'

#8 - 4" W. Pine S64W 97.55'

#3 - Pine Stump S10W 47.8'

OSCEOLA COUNTY
REGISTER OF DEEDS

99 SEP -3 AM 11:48

Wm. C. Campbell

SURVEY &
REMONUMENTATION

NOV 01 1999

SECTION