

**SURVEY &  
REMONUMENTATION**

SEP 15 1994

**LAND CORNER RECORDATION CERTIFICATE**

LIBER A PAGE 172

**COMMISSION Filing Requirement of Act 74, Mich. P.A. 1970**

For corners in

Osceola  
(County)

Located In:

Corner Code ~~##~~

- |                                       |                          |             |
|---------------------------------------|--------------------------|-------------|
| 1. Public Land Survey                 | T <u>19N</u> R <u>8W</u> | <u>M-11</u> |
|                                       | T _____ R _____          | _____       |
|                                       | T _____ R _____          | _____       |
|                                       | T _____ R _____          | _____       |
| 2. Property Controlling<br>in Section | S _____ T _____ R _____  | _____       |
|                                       | S _____ T _____ R _____  | _____       |
| 3. Miscellaneous<br>Property in Sec.  | S _____ T _____ R _____  | _____       |
|                                       | S _____ T _____ R _____  | _____       |

**APPROVED LAND CORNER  
P.A. 345 OF 1990  
Osceola County**

*Matthew A. McClung*  
26 July 1994

**Register of Deeds Stamp & File Number**

4. Lot No. \_\_\_\_\_, Recorded Plat \_\_\_\_\_  
5. Private Claims \_\_\_\_\_

I, Matthew McClung a field survey on 25 July, 191994 do hereby certify that under requirements of P.A. 74, Michigan P.A. of 1970, the corner points mentioned in lines 1 and 2 above were in conformance with regulations and rules therefore as required in the current manual of survey instructions of the United States Department of the Interior, Bureau of Land Management or by a decree of a Court of Law and/or that the corner points mentioned in lines 3, 4 and 5 above were in conformance with the rules of the Michigan Board of Land Surveyors or by a Decree of a Court of Law; established, re-established, monumented, re-monumented, recovered, found as expressed below:

**NOTE: Not more than 4 corners, all in the same town and range, may be recorded on this certificate.**

	A	B	C	D	E	F	G	H	I	J	K	L	M
2	6	5	4	3	2	1							
3													
4	7	8	9	10	11	12							
5													
6	18	17	16	15	14	13							
7													
8	19	20	21	22	23	24							
9													
10	30	29	28	27	26	25							
11													
12	31	32	33	34	35	36							
13													


A. Description of original monument and accessories and/or subsequent restoration:

The corner was set by deputy surveyor John Hodgson on December 8, 1837.  
Set wood post 40.00 chains from the South.  
Beech 7" S73W 15 Lks.  
Lynn 16" N58W 34 lks.

From 1891 to 1904 approximately, Osceola County had a remonumentation program, in which surveyors Temple and Trumbull, did the work. For the most part, a 3" glazed tile filled with cinders from a forge, were placed at each government set corner in the township. There were supposed to be 3 tile per corner, placed atop of each other, (continued on back)

B. Description of corner evidence found and/or method applied in restoring or reestablishing corner:

Found 1/2" re-bar 2" below road surface, 2' long. removed re-bar and excavated to 26" and found 2" X 2" wood stake surrounded by large stones. Notes call for tile and wood stake. Set Osceola County Monument over wood stake, which is 3" S40W of position of rebar. Monument is 6" below road surface.

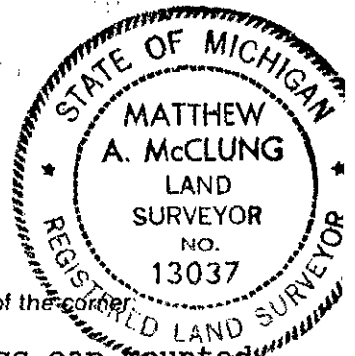

C. Description of monument for corner and accessories established to perpetuate locating the position of the corner:

Corner M-11. is Osceola County Monument, which is a 3" brass cap mounted on a 1" pipe 18" in length.  
12" W. Pine S20W 60.35 feet.  
12" W. Pine S20W 60.35 feet.  
12" W. Pine S60W 66.8 feet.  
Rock 4' X 2' X 18" above ground S35W 52.654 feet.  
Rock 3' X 4' X 2' thick, with point in center to North, S18W 62.3 feet. O.B.P.

Signed by *Matthew A. McClung*

Date July 23, 1994

Surveyor's Michigan License No. 13037

OSCEOLA COUNTY  
REGISTER OF DEEDS

94 AUG 19 PM 3:29

*Nancy Crawford*

thereby making the corner 4 feet long. Sometimes a solid tile, with a cross in the top was used, and sometimes a 1/2" iron bars were added to the tile. Notes of the work were kept in ledgers, and given to the townships, and 5 of the townships have been recorded in the County records.

One Page from the Township book shows the corner to be tile and wood stake, with witness to rock.