

LAND CORNER RECORDATION CERTIFICATE
Filing Requirement of Act 74, Mich. P.A. 1970

For corners in
BOCEOLA
 (County)

Located In: _____ Corner Code =# _____

- | | | | | | | |
|------------------------------------|---|------------|---|-----------|-----------------|-------|
| 1. Public Land Survey | T | <u>20N</u> | R | <u>9W</u> | <u>A-1, B-1</u> | |
| | T | _____ | R | _____ | _____ | |
| | T | _____ | R | _____ | _____ | |
| | T | _____ | R | _____ | _____ | |
| 2. Property Controlling in Section | S | _____ | T | _____ | R | _____ |
| | S | _____ | T | _____ | R | _____ |
| 3. Miscellaneous Property in Sec. | S | _____ | T | _____ | R | _____ |
| | S | _____ | T | _____ | R | _____ |

Register of Deeds Stamp & File Number

4. Lot No. _____, Recorded Plat _____
5. Private Claims _____

I, CARL F. ROSER, in a field survey on 2-28, 19 91, do hereby certify that under requirements of P.A. 74, Michigan P.A. of 1970, the corner points mentioned in lines 1 and 2 above were in conformance with regulations and rules therefore as required in the current manual of survey instructions of the United States Department of the Interior, Bureau of Land Management or by a decree of a Court of Law and/or that the corner points mentioned in lines 3, 4 and 5 above were in conformance with the rules of the Michigan Board of Land Surveyors or by a Decree of a Court of Law; established, re-established, monumented, re-monumented, recovered, found as expressed below:

NOTE: Not more than 4 corners, all in the same town and range, may be recorded on this certificate.

	A	B	C	D	E	F	G	H	I	J	K	L	M
2	6	5	4	3	2	1							
3													
4	7	8	9	10	11	12							
5													
6	18	17	16	15	14	13							
7													
8	19	20	21	22	23	24							
9													
10	30	29	28	27	26	25							
11													
12	31	32	33	34	35	36							
13													

~~A. Description of original monument and accessories and/or subsequent restoration:~~

A-1	B-1
	- C. CONT. -
	SE COR SEC 31
	T21N R9W N89°12'E 65.87'
	2°ELN S70°E 8.79'


• = NSHD NIT.

B. Description of corner evidence found and/or method applied in restoring or reestablishing corner:

A-1	B-1
FD 3/4" PIPE FOR NW COR OF SEC 6 AS SET S.P. BY NSHD IN 1943 US-131 RELOCATION SURVEY. OLD E-W B.WIRE IN TREES IS NORTH 16'±.	FD 1/2" ROD IN TILE FOR N1/4 COR SEC 6. NSHD FD & ACCEPTED ROD & TILE IN 1943 SURVEY FOR RELOCATION OF US-131. OLD E-W FENCE REMAINS IS 4'± SOUTH.

C. Description of monument for corner and accessories established to perpetuate locating the position of the corner:

A-1	B-1
FD 3/4" x 18" PIPE, PUSHED IN 1" x 8" BALV PIPE W/BWR CAP; SET CED POST.	FD OLD 1/2" x 32" IRON ROD IN 3" TILE; ADDED 1/2" x 50" BALV PIPE & SET CED POST W/LDC TAB.
•16" MAPLE S85°E 60.05'	•FD 12"ELM STP DUE WEST 33.33 (FD NAIL & TAB)
4" ELN S85°E 12.48'	•FD ELN STP REMAIN N60°W 17.11 (FD NAIL & TAB)
2" BALSAM S15°W 15.78'	2" ELN S20°E 26.04'
2" BALSAM N55°W 27.85'	CTR RR TRACKS DUE E 215'
S1/4 SEC 31	- CONT ABOVE -
T21N R9W } S89°11'W 236.4'	

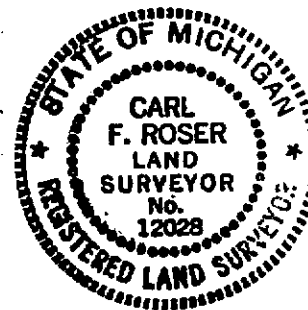

Signed by Carl F. Roser 03-16-91 Date _____
 Surveyor's Michigan License No. 12028