



OSCEOLA COUNTY  
REGISTER OF DEEDS


99 JUN -4 PM 5:02

*Nancy Crawford*

SURVEY &  
REMONUMENTATION

NOV 01 1999

SECTION

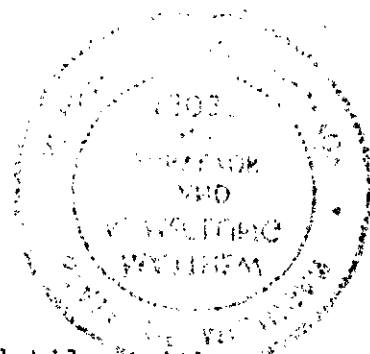

thereby making the corner 4 feet long. Sometimes a solid tile, with a cross in the top was used, and sometimes a 1/2" iron bars were added to the tile. Notes of the work were kept in ledgers, and given to the townships, and 5 of the townships have been entered in the County surveyors records

Act 132  
Liber 320 Page 73  
Dated: 15 Apr 1975 by Erickson  
PK nail in intersection  
Power Pole N45E 65.09 ft.  
Power Pole S80W 80.28 ft.  
Center top of Tele. Riser  
S40E 90.70 ft.

Act 74  
Liber 1, Page 344  
Dated 15 Apr 1975 by Erickson  
Fd. PK Nail in intersection  
Witnesses same as Act 132.

Act 132  
Liber 329, Page 327  
Dated: 17 Jun 1976 by Erickson  
Fd. P.K. Nail  
P. Pole N45W 99.73 ft. Fd.  
T. Pole S75W 80.0 ft. Fd.  
Str. Sign Post S55W 51.60 ft. Fd.  
P. Pole N45E 65.20 ft. fd.

Act 132  
Liber 643, Page 467 & 468  
Dated: 23 Jul 1998 by McClung  
P.K. Nail  
P. Pole S78W 80.01 ft.  
P. Pole N56W 99.7 ft.  
P. Pole N44E 65.30 ft.  
T. Pole S28E 85.25 ft.

Act 132  
Liber 643, Pages 469 and 470  
Dated: 23 Jul 1998 by McClung  
Witnesses same as above.