

FEB 24 2000

SECTION LAND CORNER RECORDATION CERTIFICATE
FILING REQUIREMENT OF ACT 74, Mich. P.A. 1970

For corners in	Located in:	Corner Code#	
<u>Osceola</u>			
1. Public Land Survey	T20N	R9W	C-10
	T	R	
	T	R	
	T	R	
2. Property Controlling in Section	T	R	
	S	T	R
3. Miscellaneous Property in Sec.	S	T	R
	S	T	R
4. Lot No. _____ Recorded Plat _____			
5. Private Claims _____			

James Campbell
99 NOV 19 PM 12:10
OSCEOLA COUNTY REGISTER OF DEEDS

Register of Deeds Stamp & File Number

	A	B	C	D	E	F	G	H	I	J	K	L	M
1													
2	6	5	4	3	2	1							
3													
4	7	8	9	10	11	12							
5													
6	18	17	16	15	14	13							
7													
8	19	20	21	22	23	24							
9													
10	30	29	28	27	26	25							
11													
12	31	32	33	34	35	36							
13													

I, Robert L. Wetherell, in a field survey on October 9, 1999, do hereby certify that under requirements of P.A. 74, Michigan P.A. of 1970, the corner points mentioned in lines 1 and 2 above were in conformance with regulations and rules therefore as required in the current manual of survey instructions of the United States Department of the Interior, Bureau of Land Management or by decree of a Court of Law and/or that the corner points mentioned in lines 3, 4, and 5 above were in conformance with the rules of the Michigan Board of Land Surveyors or by a Decree of a Court of Law; established, re-established, monumented, re-monumented, recovered, found as expressed below:

C-10 - 1/4 Corner common to Sections 29 & 30, T20N, R9W, Osceola Co., Mi.

A. Description of original monument and accessories and/or subsequent restoration:

- | | | |
|--|--|--|
| <p>1838 - S. Sibley, G.L.O.
#1 - 12" Beech S19°E 19 Links
#2 - 14" Sugar N45°W 13 Links</p> <p>1891-1904 - Temple/Trumbull
Sherman Twp. (T20N, R9W) had a remonumentation program.
3" Clay Tiles were set.</p> | <p>1975 - Matt McClung, LS 13037
L.C.R.C. - Liber 01, Pg. 391.
"Found chips of Tile set brass cap in East-West Fences".
#3 - Fence Post West 32.7'
#4 - Fence Post East 32.9'</p> | <p>1998 - Matt McClung, LS 13037
Survey recorded Liber 643, Pg. 463
Brass Cap
#5 - Fence Post S86°W 35.85'
#6 - 10" Poplar N50°W 35.35'
#7 - 5" Maple S8°W 87.55'
#8 - 14" Willow N10°W 110.33'</p> |
|--|--|--|

B. Description of corner evidence found and/or method applied in restoring of reestablishing corner:

I found the Osceola County Monument by McClung on the Westerly side of North and South two-track road. Corner is in line with old fences East and West.


Condition of the accessories are as follows: #1 Gone, #2 Gone, #3 New Post, #4 Found down, #5 Found in good condition, #6 Found in good condition, #7 Found in good condition, #8 Found in good condition.

C. Description of monument for corner and accessories established to perpetuate locating the position of the corner:

I accepted the Osceola County Monument for the marker and is accepted as a careful and faithful reestablishment of the position of the original corner.

12" Apple S29°W 72.89' (60d spike in E. side)
4" Elm S42°E 27.67' 960d spike in S.W. side
Corner Fence Post N86°W 35.62' (60d spike in S. side) #5
10" Poplar N46°W 36.21' (60d spike in S.E. side) #6

APPROVED LAND CORNER
P.A. 345 OF 1990
Osceola County
10-21-99
R. L. W.
Date Nov. 9, 1999

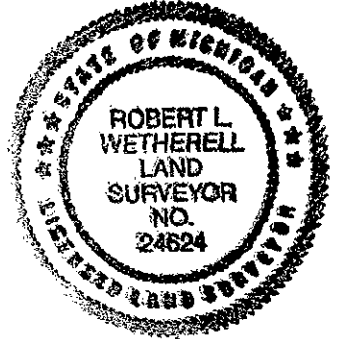

Signed by Robert L. Wetherell
Surveyor's Michigan License No. 24624