

**SURVEY &  
REMONUMENTATION**

JUN 09 1997

COMMISSION

**LAND CORNER RECORDATION CERTIFICATE  
Filing Requirement of Act 74, Mich. P.A. 1970**

For corners in  
Osceola

(County)

Located In:

Corner Code #

- |                                    |   |       |       |       |
|------------------------------------|---|-------|-------|-------|
| 1. Public Land Survey              | T | 20N   | 9W    | H-9   |
|                                    | T | _____ | _____ | _____ |
|                                    | T | _____ | _____ | _____ |
|                                    | T | _____ | _____ | _____ |
| 2. Property Controlling in Section | S | _____ | _____ | _____ |
|                                    | S | _____ | _____ | _____ |
| 3. Miscellaneous Property in Sec.  | S | _____ | _____ | _____ |
|                                    | S | _____ | _____ | _____ |

APPROVED LAND CORNER  
P.A. 345 OF 1990  
Osceola County

*Matthew McClung*  
27 April 1997

Register of Deeds Stamp & File Number

4. Lot No. \_\_\_\_\_, Recorded Plat \_\_\_\_\_  
5. Private Claims \_\_\_\_\_

I, Matthew McClung, in a field survey on 10-2, 1996 do hereby state that under requirements of P.A. 74, Michigan P.A. of 1970, the corner points mentioned in lines 1 and 2 above were in conformance with regulations and rules therefore as required in the current manual of survey instructions of the United States Department of the Interior, Bureau of Land Management or by a decree of a Court of Law and /or that the corner points mentioned in lines 3, 4 and 5 above were in conformance with the rules of the Michigan Board of Land Surveyors or by a Decree of a Court of Law, established, re-established, monumented, recovered, found as expressed below:

NOTE: Not more than 2 corners, all in the same town and range, may be recorded on this certificate.

A	B	C	D	E	F	G	H	I	J	K	L	M
1												
2	6		5		4		3		2		1	
3												
4	7		8		9		10		11		12	
5												
6	18		17		16		15		14		13	
7												
8	19		20		21		22		23		24	
9												
10	30		29		28		27		26		25	
11												
12	31		32		33		34		35		36	
13												

**A. Description of original monument and accessories and/or subsequent restoration:**

The original corner was set by deputy surveyor Sylvester Sibley on July 7, 1838. Set wood post 39.94 chains from the East.  
Tamarack 8" N89W 115 Lks.  
Pine 30" S88E 135 lks.


From 1891 to 1904 approximately, Osceola County had a remonumentation program, in which surveyors Temple and Trumbull, did the work. For the most part, a 3" glazed tile filled with cinders from a forge, were placed at each government set corner in the township. There were supposed to be 3 tile per corner, placed atop of each other, (continued on back)

**B. Description of corner evidence found and/or method applied in restoring or reestablishing corner:**

Found Osceola County Monument in willow swamp. Found old hand pump lying near position at corner.

**C. Description of monument for corner and accessories established to perpetuate locating the position of the corner:**

Corner H-9. Osceola County Monument, which is a 3" brass cap mounted on 1" pipe 18" in length.  
Centerline of old road grade North 16.65 feet.  
1" Elm N15W 7.3 feet.  
30" willow N05E 77.9 feet. O.B.T.

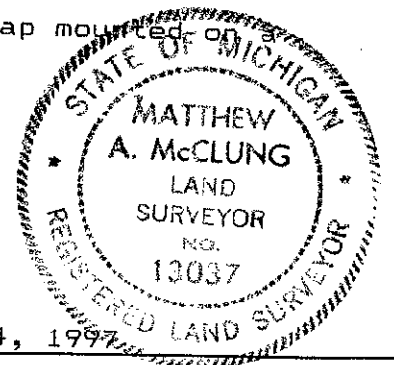

Signed by *Matthew McClung*  
Surveyor's Michigan License No. 13037

Date April 14, 1997

thereby making the corner 4 feet long. Sometimes a solid tile, with a cross in the top was used, and sometimes a 1/2" iron bars were added to the tile. Notes of the work were kept in ledgers, and given to the townships, and 5 of the townships have been entered in the County Surveyors records.

I have shown 1 LCRC: Liber 1, Page 308.

Sherman Township Book Pages 40 and 41.

OSCEOLA COUNTY  
REGISTER OF DEEDS  
97 APR 30 PM 12:32

*Yvonne Crawford*

SURVEY &  
REMONUMENTATION

JUN 09 1997

COMMISSION