

**SURVEY & REMONUMENTATION**

SEP 15 1994

**COMMISSION**

**LAND CORNER RECORDATION CERTIFICATE**

Filing Requirement of Act 74, Mich. P.A. 1970

For corners in  
Osceola  
(County)

Located In: Corner Code #

- |                                    |                          |            |
|------------------------------------|--------------------------|------------|
| 1. Public Land Survey              | T <u>20N</u> R <u>9W</u> | <u>I-5</u> |
|                                    | T _____ R _____          | _____      |
|                                    | T _____ R _____          | _____      |
|                                    | T _____ R _____          | _____      |
| 2. Property Controlling in Section | S _____ T _____ R _____  | _____      |
|                                    | S _____ T _____ R _____  | _____      |
| 3. Miscellaneous Property in Sec.  | S _____ T _____ R _____  | _____      |
|                                    | S _____ T _____ R _____  | _____      |
| 4. Lot No. _____, Recorded Plat    |                          |            |
| 5. Private Claims                  |                          |            |

APPROVED LAND CORNER  
P.A. 345 OF 1990  
Osceola County

*Matthew McClung*  
21 June 1994

Register of Deeds Stamp & File Number

I, Matthew McClung a field survey on June 15, 191994  
do hereby certify that under requirements of P.A. 74, Michigan P.A. of 1970, the corner points mentioned in lines 1 and 2 above were in conformance with regulations and rules therefore as required in the current manual of survey instructions of the United States Department of the Interior, Bureau of Land Management or by a decree of a Court of Law and/or that the corner points mentioned in lines 3, 4 and 5 above were in conformance with the rules of the Michigan Board of Land Surveyors or by a Decree of a Court of Law; established, re-established, monumented, re-monumented, recovered, found as expressed below:


**NOTE: Not more than 4 corners, all in the same town and range, may be recorded on this certificate.**

A	B	C	D	E	F	G	H	I	J	K	L	M
2	6	5	4	3	2							
3												
4	7	8	9	10	11	12						
5												
6	18	17	16	15	14	13						
7												
8	19	20	21	22	23	24						
9												
10	30	29	28	27	26	25						
11												
12	31	32	33	34	35	36						
13												

A. Description of original monument and accessories and/or subsequent restoration:  
The original corner was set by deputy surveyor Sylvester Sibley on July 7, 1838. Set wood post 80.00 chains from the South.  
Sugar 20" N35W 24 lks.  
Beech 5" S20E 12 lks.  
From 1891 to 1904 approximately, Osceola County had a remonumentation program, in which surveyors Temple and Trumbull, did the work. For the most part, a 3" glazed tile filled with cinders from a forge, were placed at each government set corner in the township. There were supposed to be 3 tile per corner, placed atop of each other, (continued on back)

B. Description of corner evidence found and/or method applied in restoring or reestablishing corner:  
Found 1/2 rod & cap by James Ray 3" below road surface. I removed rod and excavated to 45" and found no other evidence of the corner. I talked to a Mr. Martin, who lives in the SW Quadrant, and he informed the corner is buried 12 feet deep, which was agreed to by another neighbor. Erickson LCRC shows the corner to be tile and rod, also shown on McClung LCRC.s. I found the found spike "A" as shown in the private survey records, which places the corner 0.03 feet north of the Ray corner. Replaced Ray iron with Osceola County Monument, and placing Ray iron on south of monument.

C. Description of monument for corner and accessories established to perpetuate locating the position of the corner of Michigan  
Corner I-5. Osceola County Monument, which is a 3" brass cap mounted on 1" pipe 18" in length.  
14" Elm S70E 156.45 feet.  
#6" Cottonwood S30E 109.50 feet.  
Rail road tie fence post S40W 24.85 feet.  
Telephone pedestal N50W 59.80 feet.  
Stump of 36" Cottonwood S40E 69.45 feet. OBT.

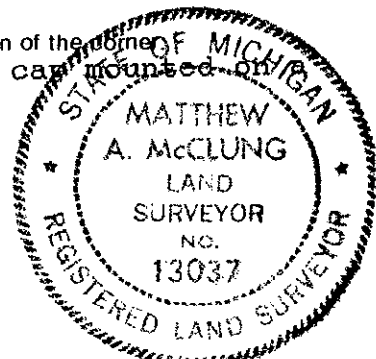

Signed by *Matthew McClung* Date June 15, 1994  
Surveyor's Michigan License No. 13037

thereby making the corner 4 feet long. Sometimes a solid tile, with a cross in the top was used, and sometimes a 1/2" iron bars were added to the tile. Notes of the work were kept in ledgers, and given to the townships, and 5 of the townships have been recorded in the County records.

This corner has three LCRC certificates recorded, One by Erickson and two by McClung.

Two PA 132 recordings by McClung.

The corner is called a tile and rod in the front pages to the Sherman Township book.

One page of private survey records.

*Yancy Campbell*  
94 JUL -7 PM 3:26  
OSCEOLA COUNTY  
REGISTER OF DEEDS