

**SURVEY & REMONUMENTATION**

SEP 15 1994

**COMMISSION**

**LAND CORNER RECORDATION CERTIFICATE**  
Filing Requirement of Act 74, Mich. P.A. 1970

For corners in  
Osceola  
(County)

Located In: Corner Code #

- |                                       |                         |       |
|---------------------------------------|-------------------------|-------|
| 1. Public Land Survey                 | T 20N R 9W              | I-6   |
|                                       | T _____ R _____         | _____ |
|                                       | T _____ R _____         | _____ |
|                                       | T _____ R _____         | _____ |
| 2. Property Controlling in Section    | S _____ T _____ R _____ | _____ |
|                                       | S _____ T _____ R _____ | _____ |
| 3. Miscellaneous Property in Sec.     | S _____ T _____ R _____ | _____ |
|                                       | S _____ T _____ R _____ | _____ |
| 4. Lot No. _____, Recorded Plat _____ |                         |       |
| 5. Private Claims _____               |                         |       |

APPROVED LAND CORNER  
P.A. 345 OF 1990  
Osceola County  
*Matthew McClung*  
25 June 1994  
Register of Deeds Stamp & File Number


I, Matthew McClung a field survey on June 15, 191994 do hereby certify that under requirements of P.A. 74, Michigan P.A. of 1970, the corner points mentioned in lines 1 and 2 above were in conformance with regulations and rules therefore as required in the current manual of survey instructions of the United States Department of the Interior, Bureau of Land Management or by a decree of a Court of Law and/or that the corner points mentioned in lines 3, 4 and 5 above were in conformance with the rules of the Michigan Board of Land Surveyors or by a Decree of a Court of Law; established, re-established, monumented, re-monumented, recovered, found as expressed below:

**NOTE: Not more than 4 corners, all in the same town and range, may be recorded on this certificate.**

	A	B	C	D	E	F	G	H	I	J	K	L	M
2	6		5		4		3		2		1		
3													
4	7		8		9		10		11		12		
5													
6	18		17		16		15		14		13		
7													
8	19		20		21		22		23		24		
9													
10	30		29		28		27		26		25		
11													
12	31		32		33		34		35		36		
13													

A. Description of original monument and accessories and/or subsequent restoration:  
The original corner was set by deputy surveyor Sylvester Sibley on July 7, 1838. Set wood post 40.00 chains from the South.  
Beech 5" N19W 20 lks.  
Lynn 5" S14 1/2E 23 lks.  
From 1891 to 1904 approximately, Osceola County had a remonumentation program, in which surveyors Temple and Trumbull, did the work. For the most part, a 3" glazed tile filled with cinders from a forge, were placed at each government set corner in the township. There were supposed to be 3 tile per corner, placed atop of each other, (continued on back)

B. Description of corner evidence found and/or method applied in restoring or reestablishing corner:  
Found Osceola County Monument 2" below Road surface. Monument had been driven over a rod & cap. Road was 1 foot long at a depth of 24". Found what appears to be a leaf spring from a truck. Excavated to a depth of 44" and spring was still solid in soil, found no tile. It appears that the tile could be buried 6 to 7 feet below the road surface.

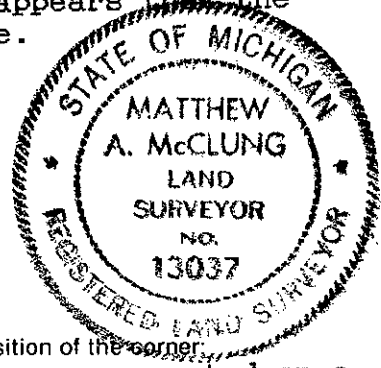

C. Description of monument for corner and accessories established to perpetuate locating the position of the corner:  
Corner I-6. Osceola County Monument, which is a 3" brass cap mounted on a 1" pipe 18" in length.  
Power pole S25W 145.6 feet. OBP.  
10" N. Pine East 49.05 feet.  
12" Spruce N60E 34.3 feet.  
Top most point of rock, closest to road, N45W 34.20 feet.

Signed by Matthew McClung Date June 15, 1994  
Surveyor's Michigan License No. 13037

thereby making the corner 4 feet long. Sometimes a solid tile, with a cross in the top was used, and sometimes a 1/2" iron bars were added to the tile. Notes of the work were kept in ledgers, and given to the townships, and 5 of the townships have been recorded in the County records.

This corner has a LCRC certificate recorded by McClung.

A PA 132 recording by McClung.

The corner is called a iron on page 45 of the Sherman Township book.

*James Crawford*

94 JUL -7 PM 3:26

OSCEOLA COUNTY  
REGISTER OF DEEDS