

**SURVEY &
RECORD DOCUMENTATION**

SEP 15 1994

**LAND CORNER RECORDATION CERTIFICATE
Filing Requirement of Act 74, Mich. P.A. 1970**

For corners in **COMMISSION**
Osceola
(County)

Located In: Corner Code #

- | | | |
|------------------------------------|--------------------------|------------|
| 1. Public Land Survey | T <u>20N</u> R <u>9W</u> | <u>K-7</u> |
| | T _____ R _____ | _____ |
| | T _____ R _____ | _____ |
| | T _____ R _____ | _____ |
| 2. Property Controlling in Section | S _____ T _____ R _____ | _____ |
| | S _____ T _____ R _____ | _____ |
| 3. Miscellaneous Property in Sec. | S _____ T _____ R _____ | _____ |
| | S _____ T _____ R _____ | _____ |

APPROVED LAND CORNER
P.A. 345 OF 1990
Osceola County

Matthew McClung
21 June 1994

Register of Deeds Stamp & File Number

4. Lot No. _____, Recorded Plat _____
5. Private Claims _____

	A	B	C	D	E	F	G	H	I	J	K	L	M
2	6	5	4	3	2	1							
3													
4	7	8	9	10	11	12							
5													
6	18	17	16	15	14	13							
7													
8	19	20	21	22	23	24							
9													
10	30	29	28	27	26	25							
11													
12	31	32	33	34	35	36							
13													

I, Matthew McClung a field survey on June 18, 19 1994 do hereby certify that under requirements of P.A. 74, Michigan P.A. of 1970, the corner points mentioned in lines 1 and 2 above were in conformance with regulations and rules therefore as required in the current manual of survey instructions of the United States Department of the Interior, Bureau of Land Management or by a decree of a Court of Law and/or that the corner points mentioned in lines 3, 4 and 5 above were in conformance with the rules of the Michigan Board of Land Surveyors or by a Decree of a Court of Law; established, re-established, monumented, re-monumented, recovered, found as expressed below:

NOTE: Not more than 4 corners, all in the same town and range, may be recorded on this certificate.


A. Description of original monument and accessories and/or subsequent restoration:

The original corner was set by deputy surveyor Sylvester Sibley on July 7, 1838. Set wood post 80.00 chains from the South.
Beech 8" S42 1/2W 48 Lks.
Sugar 4" N16E 4 lks.

From 1891 to 1904 approximately, Osceola County had a remonumentation program, in which surveyors Temple and Trumbull, did the work. For the most part, a 3" glazed tile filled with cinders from a forge, were placed at each government set corner in the township. There were supposed to be 3 tile per corner, placed atop of each other, (continued on back)

B. Description of corner evidence found and/or method applied in restoring or reestablishing corner:

Found Osceola County Monument above Road surface. Lowered to 1/2" below road surface. Monument is in the center of the road intersection. This corner was set by myself, by measuring the distance as shown on page 26 of the Sherman Township Book.

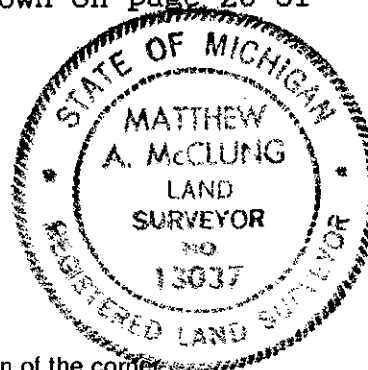

C. Description of monument for corner and accessories established to perpetuate locating the position of the corner:

Corner K-7. Osceola County Monument, which is a 3" brass cap mounted on a 1" pipe 18" in length.
West end guard rail post N75W 72.0 feet.
West end guard rail post S75W 95.0 feet.
South end guard rail post S20W 129.70 feet.
Telephone pedestal N40W 50.45 feet

Signed by Matthew McClung Date June 15, 1994
Surveyor's Michigan License No. 13037

OSCEOLA COUNTY
REGISTER OF DEEDS

94 JUL -7 PM 3:26

Mary Crawford

Liber A Page 142 .

thereby making the corner 4 feet long. Sometimes a solid tile, with a cross in the top was used, and sometimes a 1/2" iron bars were added to the tile. Notes of the work were kept in ledgers, and given to the townships, and 5 of the townships have been recorded in the County records.

This corner has Two LCRC certificates recorded by McClung.

This corner has 2 PA 132 certificates, by McClung and Wilcox.

This corner is recorded on pages 38 and 26 of the Sherman Township book.