

FEB 24 2000

SECTION

LAND CORNER RECORDATION CERTIFICATE

FILING REQUIREMENT OF ACT 74, Mich. P.A. 1970

For corners in Osceola Located in: Corner Code#

1. Public Land Survey T 20 N R 10 W A-8

2. Property Controlling in Section S T R

3. Miscellaneous Property in Sec. S T R

4. Lot No. Recorded Plat

5. Private Claims

OSCEOLA COUNTY REGISTER OF DEEDS
 99 DEC 23 PM 4:22
 Register of Deeds Stamp & File Number

A	B	C	D	E	F	G	H	I	J	K	L	M
1												
2	6	5	4	3	2	1						
3												
4	7	8	9	10	11	12						
5												
6	18	17	16	15	14	13						
7												
8	19	20	21	22	23	24						
9												
10	30	29	28	27	26	25						
11												
12	31	32	33	34	35	36						
13												

I, Robert L. Wetherell, in a field survey on November 12, 1999, do hereby certify that under requirements of P.A. 74, Michigan P.A. of 1970, the corner points mentioned in lines 1 and 2 above were in conformance with regulations and rules therefore as required in the current manual of survey instructions of the United States Department of the Interior, Bureau of Land Management or by decree of a Court of Law and/or that the corner points mentioned in lines 3, 4, and 5 above were in conformance with the rules of the Michigan Board of Land Surveyors or by a Decree Of a Court of Law; established, re-established, monumented, re-monumented, recovered, found as expressed below:

A-8 - West 1/4 corner Section 19, T20N, R10W, Osceola Co., Mi.

A. Description of original monument and accessories and/or subsequent restoration:

1838 - S. Sibley, G.L.O.
 #1 - 16" Beech S18°W 18 Links
 #2 - 12" Hemlock N15°W 10 Links

1909 - Twp. Book
 #3 - Distance North to Sec. Cor. Is 2693.46'

B. Description of corner evidence found and/or method applied in restoring or reestablishing corner:

I found a narrow gage railroad rail 24" in length. Corner is in old fence lines East and West and is 3 feet more or less West of the center of road North and South. The difference between my measurement North and that of 1909 (23.1') is consistent with a 1909 measurement from the N.W. corner of Section 19 to the N. 1/4 cor. Sec. 19. (1909 = 2494.80'; 1999 = 2519.2')

Condition of the accessories are as follows: #1 Gone, #2 Gone, #3 Measured distance North 2716.60'

C. Description of monument for corner and accessories established to perpetuate locating the position of the corner:


I replaced the railroad rail with a 1-1/2" Pipe with Osceola County Remon Cap, and is accepted as a careful and faithful reestablishment of the position of the original corner.

- 7" W. Pine S46°E 48.97' (60d spike in N.E. side)
- 12" W. Pine S9°E 124.23' (60d spike in N.E. side)
- Power Pole S75°W 136.14' (P.K. Nail in S. side)
- 6" Maple S39°W 48.5' (Center of Tree)

Signed by Robert L. Wetherell

Date 12/16/99

Surveyor's Michigan License No. 24624

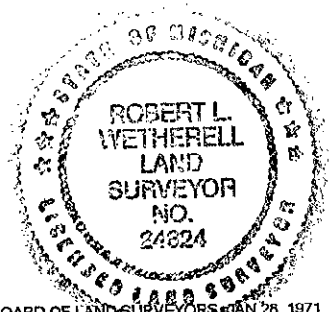

FORM APPROVED BY MICHIGAN STATE BOARD OF LAND SURVEYORS, JAN. 28, 1971
 REVISED MAY 14, 1975
 REVISED JAN., 1983
 ADAPTED FOR WORD PROCESSING JANUARY, 1999

APPROVED LAND CORNER
 P.A. 345 OF 1990
 Osceola County

12/9/99

Robert L. Wetherell